

YAZOO
19
2-18-76

MISSISSIPPI
BOARD OF WATER COMMISSIONERS
416 North State Street
Jackson, Mississippi 39201

COPIED

WATER WELL DRILLERS LOG

2-18 1976 Dyet-Sullivan YAZOO
date well completed firm name county well located

LANDOWNER: James Coleman
P.R.
Carter, Miss
(mailing address)


description of formations encountered	from	to
CLAY	0	28
FINE SAND	28	42
SAND & GRAVEL	42	121

WELL LOCATION:
1922 T-131N R-2 E
SEC 8 W
4 miles S-E of CARTER
(distance) (direction) (nearest town)

WELL PURPOSE: FISH POND
(home, irrigation, municipal, industrial)

- WELL COMPLETION DATA:
- (1) diameter (inches) 16
 - (2) total depth (feet) 121'
 - (3) static water level (feet) 19 below top of ground.
 - (4) casing Steel, 81' (material) (depth)
16" (size) if telescope see back.
 - (5) screen 40' (length), 81' (depth to top)
16 (size), Steel (material)
 - (6) pump 60 (HP), 2800 (yield gpm)
Diesel (type power)
 - (7) electric log NO (yes or no)
 - (8) how well bottom plugged DATE

DRILLERS REMARKS:

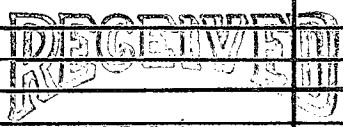


MAR 11 1976

(X)

If well telescopes please sketch and show depths.

GROUND LEVEL

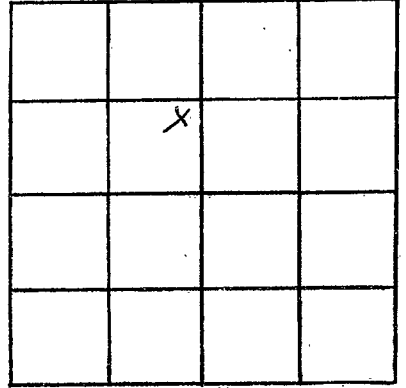

SECTION _____

Please indicate well location X.

ADDITIONAL INFORMATION

If more than one screen,
show locations of each on sketch.