

**MISSISSIPPI
BOARD OF WATER COMMISSIONERS**
416 North State Street
Jackson, Mississippi 39201

CODED

WATER WELL DRILLERS LOG

CODED

YAZOO
A 20
2-24-69

2-24 1969 DYER Well + IRR Ser YAZOO
date well completed firm name county well located

LANDOWNER:
James Coleman
RR YAZOO CITY, MISS
(mailing address)

description of formations encountered	from	to
Clay	0	13
Clay & Fine Sand.	13	73
Fine Sand.	73	33
✓	33	43
✓	43	53
✓	53	63
Med Sand 5' Fine Sand	63	73
Coarse Sand + Gravel	73	83
" "	83	93
" "	93	103
" "	103	110

WELL LOCATION:
sec 20 T 13 N R 2 1/2
2 1/2 miles S.E. of CARTER
(distance) (direction) (nearest town)

WELL PURPOSE: FISH
(home, irrigation, municipal, industrial)

WELL COMPLETION DATA:

- (1) diameter (inches) 16"
- (2) total depth (feet) 110'
- (3) static water level (feet) 24' below above top of ground.
- (4) casing BLK IR. 70
(material) (depth)
16" if telescope see back.
(size)
- (5) screen 40' 70'
(length) (depth to top)
16" BLK IR
(size) (material)
- (6) pump 60 3,000
(HP) (yield gpm)
BUTANE
(type power)
- (7) electric log NO
(yes or no)
- (organization running log)
- (8) how well bottom plugged Plate

DRILLERS REMARKS:



MAR 18 1969

MISSISSIPPI BOARD OF WATER COMMISSIONERS



If well telescopes please sketch and show depths.

GROUND LEVEL

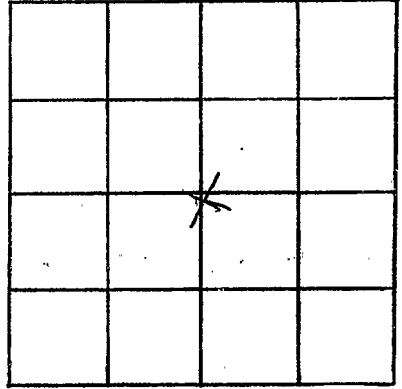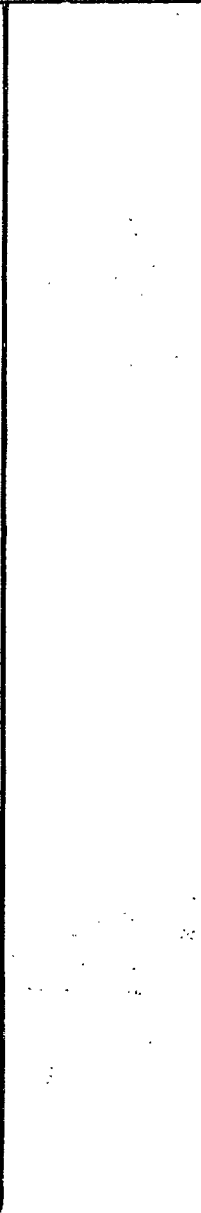

SECTION 20

Please indicate well location X.

ADDITIONAL INFORMATION

Series of horizontal lines for entering additional information.

If more than one screen, show locations of each on sketch.