

Yazoo  
A 27  
4-20-80  
Flg #285

MISSISSIPPI  
BOARD OF WATER COMMISSIONERS  
416 North State Street  
Jackson, Mississippi 39201

CODED

WATER WELL DRILLERS LOG

4-20-80 date well completed      Softcoat Drilling Co. firm name      Yazoo county well located

LANDOWNER:  
Rohney Henderson  
Eden Fishery  
(mailing address)

WELL LOCATION:  
sec. 4 T. 13 N R. 2 E  
4 1/2 miles West of Eden  
(distance) (direction) (nearest town)

WELL PURPOSE:  
(home, irrigation, municipal, industrial)

WELL COMPLETION DATA:

- (1) diameter (inches) \_\_\_\_\_
- (2) total depth (feet) 900 ft.
- (3) static water level (feet) 25 <sup>below</sup> ~~above~~ top of ground.
- (4) casing 4" stainless steel  
(material) (depth)  
4" if telescope see back.  
(size)
- (5) screen coff.  
(length) (depth to top)  
4"  
(size) (material)
- (6) pump 7 1/2 HP, 150 gpm  
(HP) (yield gpm)
- (type power) \_\_\_\_\_
- (7) electric log MS  
(yes or no)  
MS  
(organization running log)
- (8) how well bottom plugged steel plugged

description of formations encountered	from	to
clay	0	25
sand	25	60
gravel	60	110
sand	110	160
shale	160	270
sand	270	360
shale	360	586
sand	586	686
shale	686	812
sand	812	876

T.D. 900

DEPT. OF NATURAL RESOURCES  
BUREAU OF LAND & WATER RESOURCES


OCT 31 1980

RECEIVED

DRILLERS REMARKS:

If well telescopes please sketch and show depths.

GROUND LEVEL

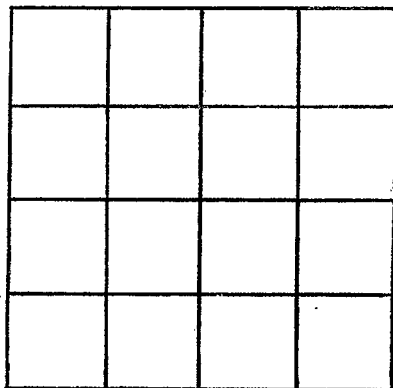

SECTION \_\_\_\_\_

Please indicate well location X.

ADDITIONAL INFORMATION

Lined area for additional information.

If more than one screen, show locations of each on sketch.