

Yazoo  
A-29  
6/31/80

MISSISSIPPI  
BOARD OF WATER COMMISSIONERS  
416 North State Street  
Jackson, Mississippi 39201

CODED

WATER WELL DRILLERS LOG

6/31 1980 DYER WELL + IRR YAZOO  
date/well completed firm name county well located

LANDOWNER:  
JAMES COLEMAN  
CARTER MISS  
(mailing address)

description of formations encountered	from	to
Clay	0	30
fine sand	30	45
sand	38	48
Sand & Gravel	38	120

WELL LOCATION:  
sec. 29 T. 13N R. 2E  
S 5 W  
3 miles SE of CARTER  
(distance) (direction) (nearest town)

WELL PURPOSE:  
(home, irrigation, municipal, industrial)

WELL COMPLETION DATA:

(1) diameter (inches) 16

(2) total depth (feet) 120

(3) static water level (feet) 20 below above top of ground.

(4) casing STEEL 80  
(material) (depth)  
16 if telescope see back.  
(size)

(5) screen 40 80  
(length) (depth to top)

16 STEEL  
(size) (material)

(6) pump 60 3000  
(HP) (yield gpm)  
DIESEL  
(type power)

(7) electric log No  
(yes or no)

(organization running log)

(8) how well bottom plugged STEEL  
PLATE

DRILLERS REMARKS:


DEPT OF NATURAL RESOURCES  
BUREAU OF LAND & WATER RESOURCES  
SEP 18 1980  
RECEIVED

P

If well telescopes please sketch and show depths.

W

GROUND LEVEL

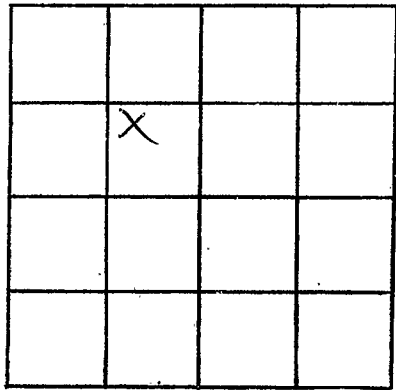

SECTION 29

Please indicate well location X.

ADDITIONAL INFORMATION

Lined area for additional information.

If more than one screen, show locations of each on sketch.