

MISSISSIPPI DEPARTMENT OF NATURAL RESOURCES

Bureau of Land and Water Resources

Southport Mall

P.O. Box 10631

Jackson, Mississippi 39209

BUTANE GAS & WATER WELLS DRILLERS LOG
POST OFFICE BOX 1135

GREENWOOD, MISS. 38930

Yagoo
A33
7-7-81


7-7-81 date well completed

firm name

Yagoo county well located

LANDOWNER:	description of fomations encountered	CODED	
		from	to
<u>Mark Sharp</u>	<u>CLAY</u>	<u>0</u>	<u>10</u>
<u>Yagoo City, Mo.</u> (mailing address)	<u>fine SAND</u>	<u>10</u>	<u>30</u>
	<u>SAND</u>	<u>30</u>	<u>70</u>
	<u>SAND & GRAVEL</u>	<u>70</u>	<u>110</u>
WELL LOCATION:			
sec <u>22</u> T <u>B</u> N R <u>2</u> E			
<u>8.3</u> miles <u>N</u> of <u>Yagoo City</u>			
(distance) (direction) (nearest town)			
WELL PURPOSE: <u>IRRIGATION</u>			
(home, irrigation, municipal, industrial)			
WELL COMPLETION DATA:			
(1) diameter (inches) <u>16"</u>			
(2) total depth (feet) <u>110</u>			
(3) static water level (feet) <u>25</u> <u>below</u> above top of ground.			
(4) casing <u>Steel</u> , <u>70</u>			
(material) (depth)			
<u>16"</u> if telescope see back.			
(size)			
(5) screen <u>40</u> , <u>70</u>			
(length) (depth to top)			
<u>16"</u> , <u>Steel</u>			
(size) (material)			
(6) pump <u>200</u> <u>2200</u>			
(HP) (yield gpm)			
<u>Diesel</u>			
(type power)			
(7) electric log _____			
(yes or no)			
(organization running log)			
(8) how well bottom plugged: <u>Steel plate</u>			
DRILLERS REMARKS:			


CODED

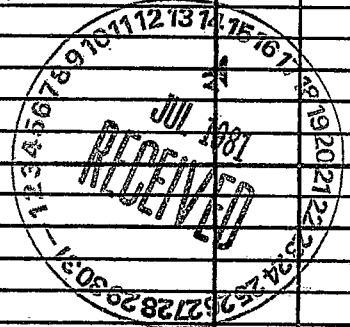

B

If well telescopes please sketch and show depths.

GROUND LEVEL

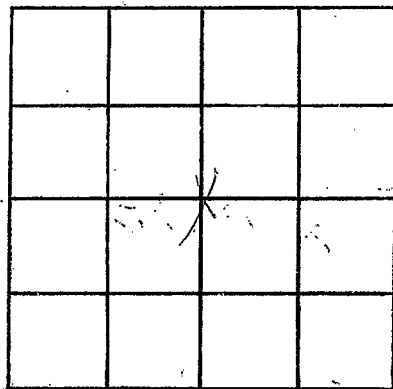

SECTION 22

Please indicate well location X.

ADDITIONAL INFORMATION

If more than one screen,
show locations of each on sketch.