

MISSISSIPPI DEPARTMENT OF NATURAL RESOURCES

Bureau of Land and Water Resources

Southport Mall

P.O. Box 10631

Jackson, Mississippi 39209

WATER WELL DRILLERS LOG

CODED

| |
|---------|
| VAZOO |
| A35 |
| 7-15-80 |

7/15/80 19 Larry's Well & Pump VAZOO
 date well completed firm name county well located

LANDOWNER: Steve Biggers

description of formations encountered

from to

Trilite Form

clay 0 20

Silver City MS
(mailing address)

fine sand 20 40

WELL LOCATION:

med sand 40 70

sec. 5 T. 13 N. R. 2 E

coarse sand & gravel 70 124

2 miles NE of Center
(distance) (direction) (nearest town)

WELL PURPOSE: fine sand
(home, irrigation, municipal, industrial)

WELL COMPLETION DATA:

CODED

(1) diameter (inches) 16"

(2) total depth (feet) 124'

(3) static water level (feet) 24' below top of ground.

(4) casing Steel, 84'
(material) (depth)

 If telescope see back.
(size)

(5) screen 40', 84'
(length) (depth to top)

16", Steel
(size) (material)

(6) pump 60, 3000
(HP) (yield gpm)

(type power)

(7) electric log No
(yes or no)

(organization running log)

(8) how well bottom plugged Steel Plate

DRILLERS REMARKS:


RECEIVED
 OCT 15 1980
 8:51

DEPT. OF NATURAL RESOURCES
 BUREAU OF LAND & WATER RESOURCES

OCT 15 1980
 RECEIVED

If well telescopes please sketch and show depths.

GROUND LEVEL

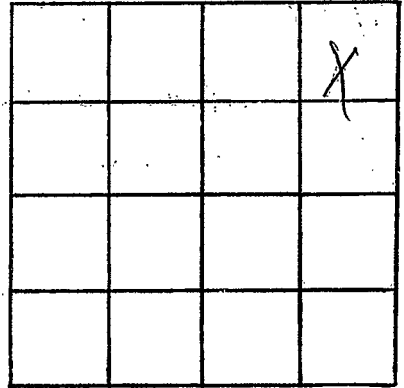

SECTION 5

Please indicate well location X.

ADDITIONAL INFORMATION

If more than one screen,
show locations of each on sketch.