

MISSISSIPPI DEPARTMENT OF NATURAL RESOURCES

Bureau of Land and Water Resources

Southport Mall

P.O. Box 10631

Jackson, Mississippi 39209

WATER WELL DRILLERS LOG

CODED

YAZOO
A39
11/13/80

11/13 1980 date well completed Larry's Well & Pump firm name Yazoo county well located

LANDOWNER:	description of formations encountered	from	to
Ed Dew			
Yazoo city Ms. (mailing address)	CLAY	0	10
	FINE + MED SAND	10	35
	MED + COARSE SAND	35	83

WELL LOCATION:
 sec. 1 T. 13 N R. 2E
3 miles NW of Eden
 (distance) (direction) (nearest town)

WELL PURPOSE: Fish Pond
 (home, irrigation, municipal, industrial)

- WELL COMPLETION DATA:
- (1) diameter (inches) 16"
 - (2) total depth (feet) 83'
 - (3) static water level (feet) 11 below above top of ground.
 - (4) casing Steel, 43'
 (material) (depth)
 (size) if telescope see back.
 - (5) screen 40', 43'
 (length) (depth to top)
16", Steel
 (size) (material)
 - (6) pump 40, 3000
 (HP) (yield gpm)
 (type power)
 - (7) electric log _____
 (yes or no)
 (organization running log)
 - (8) how well bottom plugged Steel plate

CODED

DEPT. OF NATURAL RESOURCES
 BUREAU OF LAND & WATER RESOURCES

OCT 15 1981


RECEIVED

DRILLERS REMARKS:

①

If well telescopes please sketch and show depths.

GROUND LEVEL

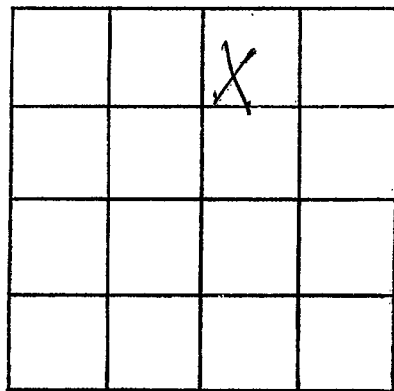

SECTION _____

Please indicate well location X.

ADDITIONAL INFORMATION

If more than one screen, show locations of each on sketch.