

MISSISSIPPI DEPARTMENT OF NATURAL RESOURCES

Bureau of Land and Water Resources

Southport Mall

P.O. Box 10631

Jackson, Mississippi 39209

WATER WELL DRILLERS LOG

CODED

Yazoo
A 40
7-31-81

July 31, 1981 date well completed
 Larry's well & pump firm name
 Yazoo county well located

LANDOWNER: Chad Phillips

description of formations encountered

from to

<u>Clay</u>	<u>0</u>	<u>28</u>
<u>fine sand</u>	<u>28</u>	<u>61</u>
<u>Coarse sand</u>	<u>61</u>	<u>116</u>

Yazoo city, Mo.
 (mailing address)

WELL LOCATION:

sec. 10 T 13 N R 2
5 miles W of Eden
 (distance) (direction) (nearest town)

WELL PURPOSE: Fish Pond
 (home, irrigation, municipal, industrial)

CODED

WELL COMPLETION DATA:

(1) diameter (inches) 16"
 (2) total depth (feet) 116'
 (3) static water level (feet) 23 below above top of ground.

(4) casing Steel, 76'
 (material) (depth)

(size) if telescope see back.

(5) screen 40', 76'
 (length) (depth to top)

16", Steel
 (size) (material)

(6) pump 100, 3000
 (HP) (yield gpm)

(type power)

(7) electric log no
 (yes or no)

(organization running log)

(8) how well bottom plugged Steel Plate

DEPT. OF NATURAL RESOURCES
 BUREAU OF LAND & WATER RESOURCES

OCT 19 1981


RECEIVED

DRILLERS REMARKS:

④

If well telescopes please sketch and show depths.

GROUND LEVEL

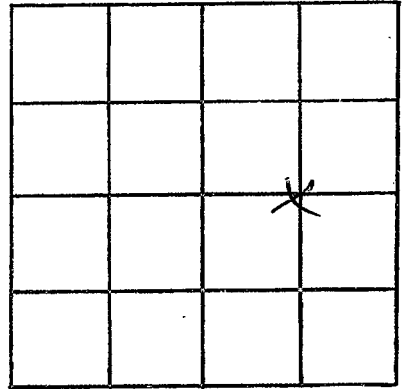

SECTION 10

Please indicate well location X.

ADDITIONAL INFORMATION

If more than one screen,
show locations of each on sketch.