

MISSISSIPPI DEPARTMENT OF NATURAL RESOURCES

Bureau of Land and Water Resources

Southport Mall

P.O. Box 10631

Jackson, Mississippi 39209

WATER WELL DRILLERS LOG

CODED

| |
|---------|
| YA200 |
| A 41 |
| 8/19/81 |

Aug 19, 1981
date well completed

Lennie Wells Pump
firm name

Way 50
county well located

LANDOWNER: Chad Phillips

description of formations encountered

from to

gagoo city ma
(mailing address)

| | | |
|-------------|----|-----|
| Clay | 0 | 30 |
| fine sand | 30 | 61 |
| Coarse Sand | 61 | 105 |

WELL LOCATION:

sec. 12 T 13 N R 2
4 miles W of Eden
(distance) (direction) (nearest town)

WELL PURPOSE: fish pond
(home, irrigation, municipal, industrial)

WELL COMPLETION DATA:

- (1) diameter (inches) 16"
- (2) total depth (feet) 105'
- (3) static water level (feet) 73 below above top of ground.
- (4) casing Steel, 65'
(material) (depth)
(size) if telescope see back.
- (5) screen 40', 65'
(length) (depth to top)
16", steel
(size) (material)
- (6) pump 60 3000
(HP) (yield gpm)
Electric
(type power)
- (7) electric log No
(yes or no)

CODED

DEPT OF NATURAL RESOURCES
BUREAU OF LAND & WATER RESOURCES

JAN 8 - 1982

RECEIVED

(organization running log)


(8) how well bottom plugged Steel Plate

DRILLERS REMARKS:



If well telescopes please sketch and show depths.

GROUND LEVEL

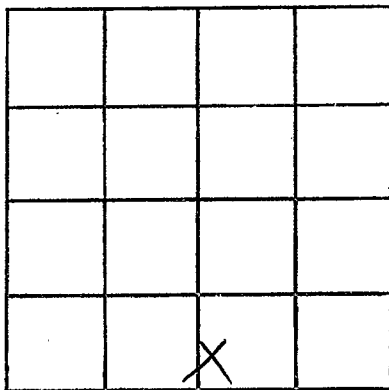

SECTION 10

Please indicate well location X.

ADDITIONAL INFORMATION

If more than one screen, show locations of each on sketch.