

MISSISSIPPI DEPARTMENT OF NATURAL RESOURCES

Bureau of Land and Water Resources

Southport Mall

P.O. Box 10631

CODED

Jackson, Mississippi 39209

WATER WELL DRILLERS LOG

BUTANE GAS COMPANY

OF GREENWOOD

firm name

*Yazoo*  
county well located

A44  
YAZOO  
5-18-84

5-18  
date well completed

19 84

LANDOWNER:  
*A.E. Edgan Jr.*  
*Yazoo City, Ms.*  
(mailing address)

description of formations encountered	from	to
<i>Clay</i>	<i>0</i>	<i>30</i>
<i>sand</i>	<i>30</i>	<i>55</i>
<i>sand + pe gravel</i>	<i>55</i>	<i>108</i>

WELL LOCATION:  
sec. *24 T 13 N S* R. *2 E*  
*2.5* miles *SW* of *Eden*  
(distance) (direction) (nearest town)

WELL PURPOSE: *Irrigation*  
(home, irrigation, municipal, industrial)

- WELL COMPLETION DATA:
- (1) diameter (inches) *16"*
  - (2) total depth (feet) *108*
  - (3) static water level (feet) *12* <sup>below</sup> top of ground.
  - (4) casing *Steel* *108 ft.*  
(material) (depth)  
*16"* if telescope see back.  
(size)
  - (5) screen *40'* *68*  
(length) (depth to top)  
*16* *Steel*  
(size) (material)
  - (6) pump *100* *1400*  
(HP) (yield gpm)  
*Diesel*  
(type power)
  - (7) electric log *No*  
(yes or no)  
*No*  
(organization running log)
  - (8) how well bottom plugged *Steel plate*

DRILLERS REMARKS:  
*Richard West sr.*

DEPT. OF NATURAL RESOURCES  
BUREAU OF LAND & WATER RESOURCES


JUN - 4 1984

RECEIVED

D

If well telescopes please sketch and show depths.

GROUND LEVEL

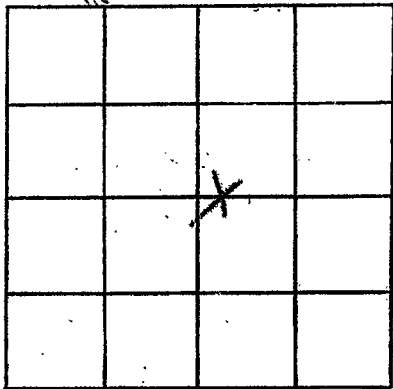

SECTION 24

Please indicate well location X.

ADDITIONAL INFORMATION

If more than one screen, show locations of each on sketch.