

MISSISSIPPI DEPARTMENT OF NATURAL RESOURCES

Bureau of Land and Water Resources

Southport Mall

P.O. Box 10631

Jackson, Mississippi 39209

WATER WELL DRILLERS LOG

CODED

VA 200
A46

June 18 1984 date well completed
Lany's Well Pump firm name
Yazoo county well located

LANDOWNER: Chat Phillips

| description of formations encountered | from | to |
|---------------------------------------|-----------|------------|
| <u>clay</u> | <u>0</u> | <u>30</u> |
| <u>Fine Sand</u> | <u>30</u> | <u>60</u> |
| <u>course sand & gravel</u> | <u>60</u> | <u>115</u> |

Yazoo City, Mo.
(mailing address)

WELL LOCATION:
sec. 10 T. 13 N R. 2 E
S W
3 miles west of Eden
(distance) (direction) (nearest town)

WELL PURPOSE: Fish Pond
(home, irrigation, municipal, industrial)

- WELL COMPLETION DATA:
- (1) diameter (inches) 6"
 - (2) total depth (feet) 115'
 - (3) static water level (feet) 27' ^{below} above top of ground.
 - (4) casing PVC, 75'
(material) (depth)
 if telescope see back.
(size)
 - (5) screen 40', 75'
(length) (depth to top)
6", PVC
(size) (material)
 - (6) pump 300 5 300
(HP) (yield gpm)
E. Oastue
(type power)
 - (7) electric log no
(yes or no)

CODED

DEPT. OF NATURAL RESOURCES
BUREAU OF LAND & WATER RESOURCES

OCT 31 1984

RECEIVED


(organization running log)
(8) how well bottom plugged PVC
cap

DRILLERS REMARKS:

①

If well telescopes please sketch and show depths.

GROUND LEVEL

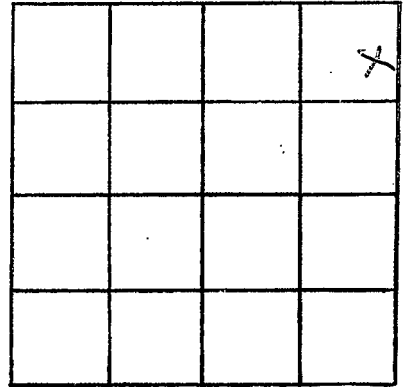

SECTION 10

Please indicate well location X.

ADDITIONAL INFORMATION

If more than one screen,
show locations of each on sketch.