

YAZOO
 YAZOO
 CL-2959
 A 47
 319/85

MISSISSIPPI DEPARTMENT OF NATURAL RESOURCES
 Bureau of Land and Water Resources
 Southport Mall
 P.O. Box 10631
 Jackson, Mississippi 39209
WATER WELL DRILLERS LOG

CODED

3-19 19 85 LAYNE CENTRAL CO. YAZOO
 date well completed firm name county well located

LANDOWNER:	description of formations encountered	from	to
EDEN FISHERIES			
YAZOO CITY, MS	fine sand	12	22
(mailing address)	med. coarse sand	22	32
WELL LOCATION:	coarse sand	32	42
sec. 15 T 13 N R 2 E	coarse sand & p.gr.	42	52
3 miles NW of Eden	coarse sand	52	82
(distance) (direction) (nearest town)	coarse sand & gravel	82	117
	clay	117	

WELL PURPOSE: irrigation
 (home, irrigation, municipal, industrial)

- WELL COMPLETION DATA:
- (1) diameter (inches) 32"
 - (2) total depth (feet) 117'
 - (3) static water level (feet) 27 below top of ground.
 - (4) casing steel 67' (material), (depth)
 16" (size) if telescope see back.
 - (5) screen 50' 67' (length), (depth to top)
 16" (size), st. steel (material)
 - (6) pump 50 2400 (HP), (yield gpm)
 electric (type power)
 - (7) electric log no (yes or no)
 (organization running log)
 - (8) how well bottom plugged st. plate

CODED

RECEIVED


AUG 30 1985

DRILLERS REMARKS:

Department of Natural Resources
 Bureau of Land and Water Resources

If well telescopes please sketch and show depths.

GROUND LEVEL

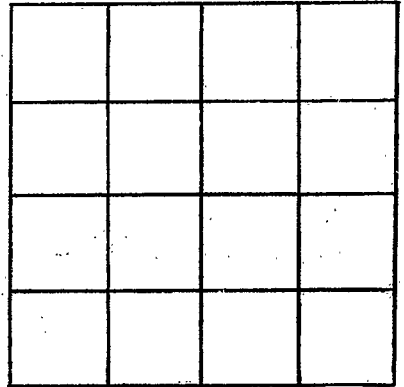

SECTION _____

Please indicate well location X:

ADDITIONAL INFORMATION

A series of horizontal lines for providing additional information, starting below the 'ADDITIONAL INFORMATION' header and extending to the bottom of the page.

If more than one screen, show locations of each on sketch.