

MISSISSIPPI DEPARTMENT OF NATURAL RESOURCES

Bureau of Land and Water Resources

Southport Mall

P.O. Box 10631

Jackson, Mississippi 39209

WATER WELL DRILLERS LOG

CODED

YAZOO  
 CL-3063  
 A 48  
 7/16/85

7/16 19 85      LAYNE-CENTRAL CO.      YAZOO  
 date well completed      firm name      county well located

LANDOWNER:  
 EDEN FISHERIES  
 YAZOO CITY, MS  
 (mailing address)

description of formations encountered	from	to
	clay	0
sand	16	32
coarse sand	32	50
coarse sand/gravel	50	116
clay	116	118

WELL LOCATION:  
 sec. 15 T 13 N R 2 E  
 2 miles NW of Eden  
 (distance) (direction) (nearest town)

WELL PURPOSE: irrigation  
 (home, irrigation, municipal, industrial)

WELL COMPLETION DATA:

(1) diameter (inches) 32"

(2) total depth (feet) 118'

(3) static water level (feet) 26' below top of ground.

(4) casing steel, 66' (material), (depth), 16" (size) if telescope see back.


(5) screen 50' (length), 66' (depth to top), 16" (size), st. steel (material)

(6) pump 60 (HP), 3000 (yield gpm), diesel (type power)

(7) electric log no (yes or no)  
 (organization running log) st. plate

(8) how well bottom plugged

CODED

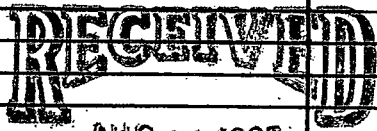


AUG 30 1985

DRILLERS REMARKS:

Department of Natural Resources  
 Bureau of Land & Water Resources

If well telescopes please sketch and show depths.

GROUND LEVEL

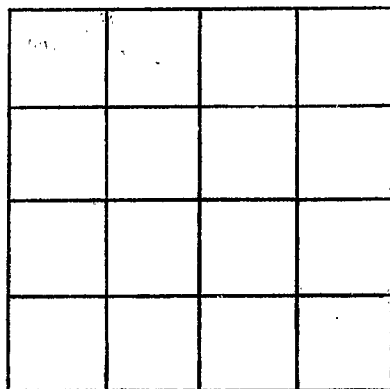

SECTION \_\_\_\_\_

Please indicate well location X.

ADDITIONAL INFORMATION

If more than one screen, show locations of each on sketch.