

MISSISSIPPI DEPARTMENT OF NATURAL RESOURCES

Bureau of Land and Water Resources

Southport Mall

P.O. Box 10631

Jackson, Mississippi 39209

WATER WELL DRILLERS LOG

CODED

YAZOO
A50

Feb 26, 1986 Lamp's well & pump Yazoo
 date well completed firm name county well located

LANDOWNER: Archie Edgar

description of formations encountered	from	to
clay	0	60
Fine Sand	60	100
Coarse Sand & gravel	100	145

Yazoo city mo
 (mailing address)

WELL LOCATION:

sec. 24 T. 13 N R. 2 E
 S 2 W
 3 miles N of Yazoo
 (distance) (direction) (nearest town)

WELL PURPOSE: Fish Pond
 (home, irrigation, municipal, industrial)

WELL COMPLETION DATA:

- (1) diameter (inches) 8"
- (2) total depth (feet) 145'
- (3) static water level (feet) 15' below above top of ground.
- (4) casing PVC (material), (depth)
 (size) If telescope see back.
- (5) screen 40 105 (length) (depth to top)
 8" PVC (size) (material)
- (6) pump 20 100 (HP) (yield gpm)
 Elec (type power)
- (7) electric log NO (yes or no)
 (organization running log)
- (8) how well bottom plugged PVC cap

CODED




SEP 25 1986

Department of Natural Resources
 Bureau of Land & Water Resources

DRILLERS REMARKS:

If well telescopes please sketch and show depths.

GROUND LEVEL

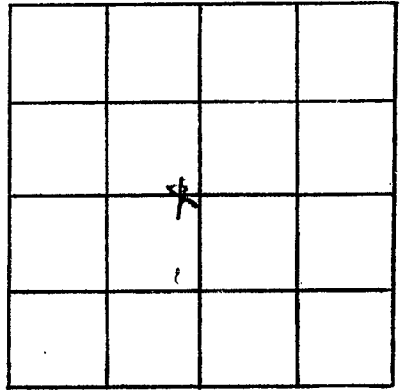

SECTION 34

Please indicate well location X.

ADDITIONAL INFORMATION

If more than one screen, show locations of each on sketch.