

MISSISSIPPI DEPARTMENT OF NATURAL RESOURCES
Bureau of Land and Water Resources
 Southport Mall
 P.O. Box 10631
 Jackson, Mississippi 39209
WATER WELL DRILLERS LOG

CODED

YAZOO
A-51

May 10 1986 Larry's Well & Pump Yazoo
 date well completed firm name county well located

LANDOWNER: Chat Phillips
Yazoo City, Ms
 (mailing address)

description of formations encountered	from	to
<u>clay</u>	<u>0</u>	<u>30</u>
<u>fine sand</u>	<u>30</u>	<u>50</u>
<u>course sand + gravel</u>	<u>50</u>	<u>106</u>

WELL LOCATION:
 sec. 15 T. 13 N R. 2 E
 3 S W
3 miles W of Eden
 (distance) (direction) (nearest town)

WELL PURPOSE: Fish Pond
 (home, irrigation, municipal, industrial)

- WELL COMPLETION DATA:
- (1) diameter (inches) 16"
 - (2) total depth (feet) 106
 - (3) static water level (feet) 26 ^{below}/_{above} top of ground.
 - (4) casing Steel, 66'
 (material) (depth)
 (size) If telescope see back.
 - (5) screen 40', 66'
 (length) (depth to top)
16", Steel
 (size) (material)
 - (6) pump 60 3600
 (HP) (yield gpm)
E
 (type power)
 - (7) electric log NO
 (yes or no)
 (organization running log)
 - (8) how well bottom plugged steel
plate

CODED


RECEIVED
SEP 20 1986

Department of Natural Resources
 Bureau of Land & Water Resources

DRILLERS REMARKS:

If well telescopes please sketch and show depths.

GROUND LEVEL

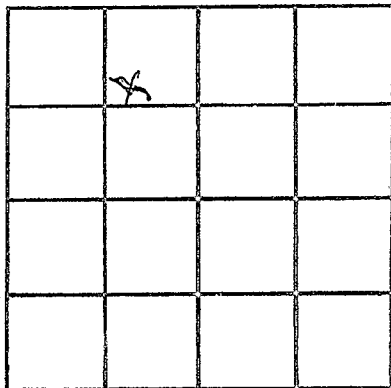

SECTION 15

Please indicate well location X.

ADDITIONAL INFORMATION

If more than one screen,
show locations of each on sketch.