

MISSISSIPPI DEPARTMENT OF NATURAL RESOURCES

Bureau of Land and Water Resources

Southport Mall

P.O. Box 10631

Jackson, Mississippi 39209

WATER WELL DRILLERS LOG

7200
A 55

CODED

March 30 19 85  
date well completed

Larry's well & pump  
firm name

7200  
county well located

LANDOWNER:

James Coleman

description of formations encountered

from

to

Yazoo city

(mailing address)

Sand

800 1000

WELL LOCATION:

sec. 17 T. 13 N. S

R. 2 E. CW

3 miles SE of Coates  
(distance) (direction) (nearest town)

WELL PURPOSE:

(home, irrigation, municipal, industrial)

WELL COMPLETION DATA:

- (1) diameter (inches) 4" x 2'
- (2) total depth (feet) 1020
- (3) static water level (feet) 19' below top of ground.
- (4) casing PVC, 4" ID, 40' (material) (depth)  
40" (size) if telescope see back.
- (5) screen 50' 2" (length) 970 to 1020 (depth to top)  
2" (size) PVC (material)
- (6) pump 2 (HP) 40 (yield gpm)  
220 (type power)
- (7) electric log NO (yes or no)

CODED

CODED

RECEIVED

DEC 17 1986

Department of Natural Resources  
Bureau of Land & Water Resources

(organization running log)

(8) how well bottom plugged - Shadk

DRILLERS REMARKS:


If well telescopes please sketch and show depths.

GROUND LEVEL

200' 4" PVC

770' 2" PVC

50' 2" PVC  
SCREEN

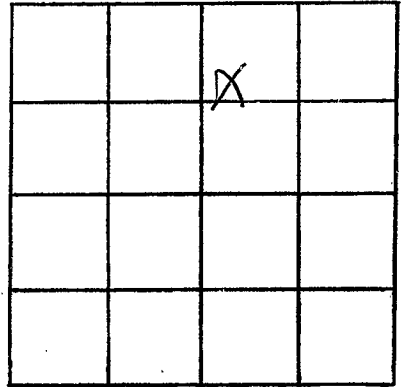

SECTION 17

Please indicate well location X.

ADDITIONAL INFORMATION

If more than one screen, show locations of each on sketch.