····	State Wall Depart	·
Yazoo	State Well Report Part 1	For Office Use Only:
County: Permit #: MS-GW- 39752	Mississippi Department of Environmental Quality	Aquifer:
Irrigation Equipment	Office of Land and Water Resources P.O. Box 10631	Well #: <u>A70</u>
	Jackson, MS 39289-0631	L. S. Elevation:
Date drilling completed: $7-27-04$	(601)961-5210 (601)354-6938 (fax)	E-log #:
State Law requires that this rep 30 days of completion of drilling	port be prepared by the driller in detail and filed w	vith the Department within
Well Owner Inform		l Location
Owner Name	hers Fish Farm Latitude: 32.58.47	" Longitude: 20.23, 37 "
Mailing Address: 4024 Money	Sunk Road Method of Lat/Long (circle o	ne): Conventional Survey
Yazoo City,		I GPS, Survey-grade GPS
	$\begin{array}{c c} \underline{\text{MS}} & \underline{\text{SF}} & \underline{\text{SF}} \\ \underline{\text{SE}} & \underline{\text{NW}} & \underline{\text{M}} & \underline{\text{Sec}} & \underline{10} \\ \hline \\ \underline{\text{ate}} & \underline{\text{Zip Code}} & \underline{10} \\ \end{array}$	Twn_13NRng_2W
Telephone No. () 746-4408	Distance Direction	Nearest Town
	Well Data	Fish Pond
Purpose of Well (circle one) Home In	dustrial Public Supply Irrigation Fish Culture	Other: Replacement
Date well drilling started: $7-27-0$	Date well drilling completed: 7-	27-04
f flowing, method of flow regulation: Va	alve Other (describe)	
	bove o beloy (circle one) land surface Date measured;	
Method of Measurement (circle one)		· · · · ·
Hole depth: 110 Well de	epth: <u>110</u> Well grouted to a depth of	<u> </u>
Type of grout (circle one): Cement	Bentonite Mix	
Casing length: <u>70</u> feet Cas	ing diameter: <u>16</u> inches Type of casing: _	PVC Sch.40
Screen length: <u>40</u> feet Scr	een diameter: <u>16</u> inches Type of screen:	PVC Sch. 40
Screen slot size:inches		
Type of completion (circle all applicable)	: travel packed Underreamed Telescoped Oper	hole Natural Development
	Other (describe):	· · · · · · · · · · · · · · · · · · ·
Top of lap pipe or reduction in casing:	feet. If telescoped or more than one sci	reen, describe on back of page
Logs run (circle all applicable): No log r	Electric Gamma Ray Density Sonic Neutron	Other:
Name of organization running log(s):		
I certify that the well was drilled, const	ructed, and completed in accordance with all applicable	 requirements of the Mississippi
Department of Environmental Quality	and/or the Mississippi Department of Health regulation:	
Irrigation Equi Patrick M. Chis		
	Tames	M Chisw
Print Name of Water Well Contractor and	License No. Signature o	f Water Well Contractor
		AUG 1
		AUG /
•		BY: O

٧R


If well telescopes please sketch below and show depths.

Ground Level

A-

Description of Formations Encountered	From	То
Clay	0	38
Fine Sand	39	55
Fine Sand/gravel	56	
Fine Sand/gravel Med. Sand/gravel	62	108
Clay	109	110
		!
		<u> </u>
· · · · · · · · · · · · · · · · · · ·		
		ļ
		
		<u> </u>
		
·		<u> </u>
·		
· · · · · · · · · · · · · · · · · · ·		
		_
		ļ
		
		<u> </u>
· · · · · · · · · · · · · · · · · · ·		
		<u> </u>
		<u> </u>
		_
		1

If more than one screen, show location of each on sketch

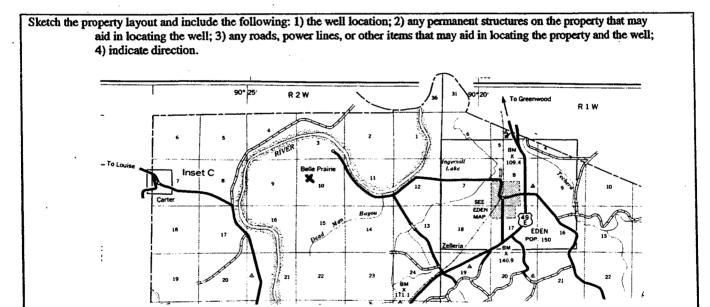

Landowner Name:______ Phillips Brothers Fish Farm

Signature of Water Well Contractor

Bucket Piston Turbine Bucket Piston Turbine Centrifugal Rotary Flowing Well Other (specify):	Part 2 Part 12 Part 2 Part 2 <td< th=""><th>•</th><th></th><th>TI I BEBODT</th><th></th><th></th></td<>	•		TI I BEBODT		
Comy Fund Package 3 completion keport Primit & MS-CM - 39 752 Irrigation Equipment Irrigation Equipment Convertion Convertional Quality Date complete: 7-28-04 State complete: 7-28-04 This report should be prepared by the pump tostaller in detail and filed with the Department within 30 days of the installeten of pump. Well Worker Information Well Worker Information Well Worker Information Well Worker Information Well Worker Information Well Conters Fish Farm Owner Name: Well Worker Information Well Worker Information Well Conters Fish Farm Mailing Address: 4024 Money Sunk Road Wall Zoo City, MS 39194 Latitude: 22:58:47 City State Zip Code Wall Societ one: Correction Nearest Town Va zoo City, MS 39194 State City State Zip Code Pump Type Credie one Credie one Distance Pump Type Credie one Credie one Distance Pump Test Data Method of Messeuring Water Level Date Pump Installed: 7-28-04 Static Wa	Const. Const. Const. Const. Const. Const. Report Prime is AGS C2A-39752 I'religation Equipment Date complexe. 7-28-04 Missing Const. Missing Const. Pollar. Date complexed. 7-28-04 Missing Const. Missing Const. Missing Const. Date complexed. 7-28-04 Missing Const. Missing Const. Missing Const. Missing Address. 4024 Money Sunk Road Well Orner Information Well Const. Yazoo City, MS 39194 City State Zip Code Yazoo City, MS 39194 City State Zip Code Yazoo City, MS 39194 City State Zip Code Pamp Type City is state City on a state Zip Code Pamp Type City on a state City on a state State Buschant State Date Pum		-		For Office	Lice Only:
Permit # (AST2N-32) T32 Office of Land and Water Resources Point # (AST2N-32) T32 Office of Land and Water Resources Point # (AST2N-32) T32 POINT # (AST2N-32) T32 Date completed: 7-28-04 Well w: A 70 Bevalue Bevalue	Permit# (INSCPN-SJ/G2- Date complete: Control Equipment Date: Office of Land and Water Resources P.O. Box 10631 Jackson, MS 39280-0631 (601)334.6938 (fm) Image: Ima				Aquifer:	
Date completed: 7-28-04 Jackson, MS 3928-0631 (601)9354-6938 (fax) Well #: (C	Date Date complexet: 7-28-04 Inclusion, MS 39289-0631 (601)354-6938 (fax) Well #:	Irrigation Equipment	Office of Land	and Water Resources		
(001):504-0355 (likt) (001):504-0355 (likt) This report should be prepared by the pump installer in detail and filed with the Department within 30 days of the installation of pump. Well Owner Information Well Owner Information Well Coation Weene Correle one Correle one Correle one Correle one Correle one </td <td>(01)534-0336 (LB) (01)534-0336 (LB) (01)534-0336 (LB) Well Correction Weil West Order Yard colspan="2">Correction Weil Scale Correction Network State Distance Distance Power Type Circle one Add Suffice Windmill Other (specify): Corelo cone <td c<="" td=""><td></td><td>Jackson,</td><td>MS 39289-0631</td></td></td>	(01)534-0336 (LB) (01)534-0336 (LB) (01)534-0336 (LB) Well Correction Weil West Order Yard colspan="2">Correction Weil Scale Correction Network State Distance Distance Power Type Circle one Add Suffice Windmill Other (specify): Corelo cone <td c<="" td=""><td></td><td>Jackson,</td><td>MS 39289-0631</td></td>	<td></td> <td>Jackson,</td> <td>MS 39289-0631</td>		Jackson,		
Well Owner Information Well Correction Phillips Brothers Fish Farm Owner Name: Well Correction Weil Correction Weil Correction Network Type Circle one Owner Type Circle one Power Type Circle one Air Lift Jet Submersible Bucket Plane Type Correction Natural Gas Date Pump Installet:	Well Owner Information Well Decetion Well Course Information Pump Type Circle one Pump Type Circle one Pump Type Circle one Pump Test Data Method of Measuring Water Level Circle one	Date completed: $7-20-04$	$\begin{array}{c} \text{tate completed:} & \underline{/-28-04} \\ \text{(601)}961-5210 \\ \text{(601)}354-6938 \\ \text{(fat} \end{array}$			
Weil Owner Information Weil Coexition Weil Coexition Weil Location Weil Coexition Weil Location Vary City MS 39194 City State Zip Code Discuest City MS Squad, Hand-Meid GPS, Survey-grade GPS Static Wait Location Pump Type Citrele one Antion of Pump Test Data Method of Measuring Mater Level <th< td=""><td>Well Dorace Information Well Location Well Carte Cone Well Carte Cone Partick Made Surface Power Type Christon Christon Outer Well Made Mater Level (Specify): Power Type Christon Outer (specify): Power Type </td></th<>	Well Dorace Information Well Location Well Carte Cone Well Carte Cone Partick Made Surface Power Type Christon Christon Outer Well Made Mater Level (Specify): Power Type Christon Outer (specify): Power Type					