

MISSISSIPPI DEPARTMENT OF NATURAL RESOURCES

Bureau of Land and Water Resources

Southport Mall

P.O. Box 10631

Jackson, Mississippi 39209

WATER WELL DRILLERS LOG

<i>Yazoo</i>
A
<i>2005</i>

July - 20 19*84* *E.M. Bud Cresswell* *Yazoo*
 date well completed firm name county well located

LANDOWNER:
Danny Daw
Yazoo City, Ms 39194
 (mailing address)

description of formations encountered	from	to
	<i>gumbo sand-gravel</i>	<i>0</i>
	<i>20</i>	<i>120</i>

WELL LOCATION:
 sec *7* T *13* N R *2* E
6 miles *West* of *Eden*
 (distance) (direction) (nearest town)

WELL PURPOSE: *drinking*
 (home, irrigation, municipal, industrial)

WELL COMPLETION DATA:

(1) diameter (inches) *2*

(2) total depth (feet) *120*

(3) static water level (feet) *10* below top of ground.

(4) casing *Steel*, *110*
 (material) (depth)
2 if telescope see back.
 (size)

(5) screen *10*, *110*
 (length) (depth to top)
2, *Stanley*
 (size) (material)

(6) pump *1*, *15*
 (HP) (yield gpm)
 (type power)

(7) electric log *no*
 (yes or no)
 (organization running log)

(8) how well bottom plugged *bad work below*

DRILLERS REMARKS:


DEPT. OF NATURAL RESOURCES
 BUREAU OF LAND & WATER RESOURCES

AUG 7 1984

RECEIVED

If well telescopes please sketch and show depths.

GROUND LEVEL

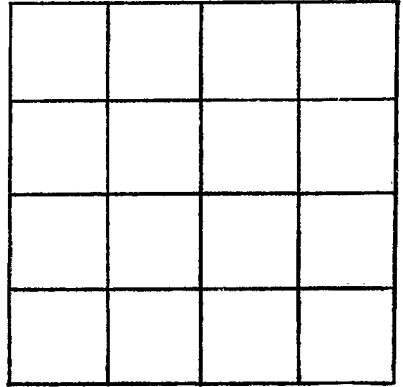

SECTION _____

Please indicate well location X.

ADDITIONAL INFORMATION

If more than one screen, show locations of each on sketch.