

MISSISSIPPI DEPARTMENT OF NATURAL RESOURCES

Bureau of Land and Water Resources

Southport Mall

P.O. Box 10631

Jackson, Mississippi 39209

WATER WELL DRILLERS LOG

YAZOO
CL-3128
A2003

9-25 1985 LAYNE CENTRAL CO. YAZOO  
 date well completed firm name county well located

LANDOWNER:	description of formations encountered	from	to
EDEN FISHERIES	clay	0	24
EDEN, MS	fine sand/clay	24	35
(mailing address)	fine sand	35	58
	pea gr./sand	58	104
	clay	104	

WELL LOCATION:  
 sec. 14 T 13 N. R. 2 W  
 5 miles N Yazoo City  
 (distance) (direction) of (nearest town)

WELL PURPOSE: Irrigation  
 (home, irrigation, municipal, industrial)

WELL COMPLETION DATA:


(1) diameter (inches) 32"  
 (2) total depth (feet) 104'  
 (3) static water level (feet) 25' below top of ground.  
 (4) casing steel, 64' (material), (depth), 16" (size) if telescope see back.  
 (5) screen 40' (length), 64' (depth to top), 16" (size), steel (material)  
 (6) pump 60 (HP), 2000 (yield gpm), elec. (type power)  
 (7) electric log no (yes or no)  
 (organization running log) st. plate  
 (8) how well bottom plugged

RECEIVED  
 NOV 14 1985

DRILLERS REMARKS:  
 Department of Natural Resources  
 Bureau of Land & Water Resources

If well telescopes please sketch and show depths.

GROUND LEVEL

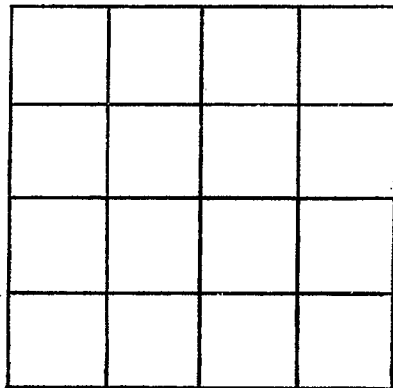

SECTION \_\_\_\_\_

Please indicate well location X.

ADDITIONAL INFORMATION

If more than one screen, show locations of each on sketch.