

MISSISSIPPI DEPARTMENT OF NATURAL RESOURCES

Bureau of Land and Water Resources

P.O. Box 10631

Jackson, Mississippi 39209

WATER WELL DRILLERS LOG

COUNTY WELL LOCATED 70200	
WELL NUMBER A	CODED
DATE WELL COMPLETED 2004 1-30-89	

188

PERMIT NUMBER
NAME OF DRILLING FIRM Seccol's Pipes Well

NAME & MAILING ADDRESS OF LANDOWNER Chat Phillips Phillips Bro. Farms			
WELL LOCATION: SEC	TOWNSHIP	RANGE	
3	13 N	2 E	W
DISTANCE	DIRECTION	NEAREST TOWN	
6 Miles	W	of Eden	
OTHER LANDMARK			
WELL PURPOSE: Home, Irrigation, Municipal, Industrial , Fish Pond, etc.			

PUMP DATA		
PUMP TYPE (Circle One): Submersible , Turbine, Jet, Flowing Well, Other (Describe) _____		
POWER TYPE (Circle One): Electric, Tractor, Diesel, Gasoline, Butane, Other (Describe) _____		
Pump Capacity (GPM)	No. of Stages	Setting Depth
85	13	105 FT.
PUMP TEST		
Well yielded 85 GPM with a drawdown of 90 ft. after 2 1/2 hours of pumping		

WELL DATA		
Well Depth 880	Casing Diameter (In.) 4x2"	Casing Length (Ft.) 820'
Type of Casing Pvc.	Hole Depth 880'	Depth to Static Water Level 36'
TYPE OF COMPLETION: (Circle One or More): Gravel Packed, Underreamed, Telescoped , Natural Development, Open Hole, Other (Describe) 4x2		
Top of Lap Pipe or Reduction in Casing 200' FEET		
IF TELESCOPED OR MORE THAN ONE SCREEN: USE BACK PAGE		

LOG DATA			
TYPE OF LOG RUN (Circle One): No Log Run , Electric, Gamma Ray, Density, Sonic, Neutron, Other (Describe) _____			
Name of Organization Running Log			

SCREEN DATA		
Diameter - Inches 2"	Length - Feet 60'	Slot Size 20/40
Screen Type P.K.	Depth to Bottom - Feet 820' & 880'	

GEOLOGIC DATA (Office Use Only)			
Surface Elev.	Geologic Unit	Unit Thickness	Depth to Top
Subs. SWL	Date	Analysis	Aquifer Test
Driller's Remarks <div style="text-align: center; font-size: 2em; font-weight: bold; opacity: 0.5;">RECEIVED</div> APR 13 1989			

DESCRIPTION OF FORMATIONS ENCOUNTERED	FROM	TO	FORMATIONS (Continued)	FROM	TO
Top	0	118	Sand	440	476
Clay	118	250	Clay	476	483
Shelly Sand	250	275	Sand	483	490
Clay	275	340	Clay	490	520
Sand "fine"	340	370	Sand	520	543
Clay	370	380	Clay	543	610
Sand	380	385	Sand "ok"	610	690
Clay	385	388	Clay	690	750
Sand	388	437	Sand Set	750	880
Clay	437	440			
IF MORE SPACE IS NEEDED, USE BACK					

If well telescopes please sketch and show depths.

GROUND LEVEL

200'

4" PVC

620'

2" PVC

60'


SCREEN

~~40-008~~

40-008

20'-010

SAND
SHAK

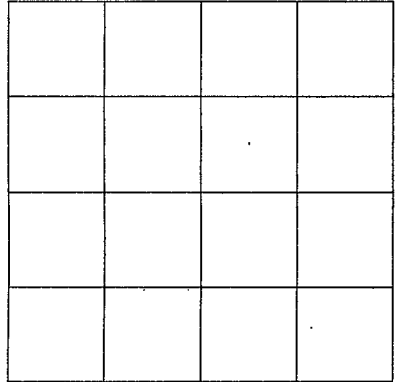

SECTION _____

Please indicate well location X.

ADDITIONAL INFORMATION

If more than one screen,
show location of each on sketch.