

MISSISSIPPI DEPARTMENT OF NATURAL RESOURCES

Bureau of Land and Water Resources

COUNTY WELL LOCATED YAZOO	
WELL NUMBER A	CODED
DATE WELL COMPLETED 2-27-91	

22-4780

PERMIT NUMBER
NAME OF DRILLING FIRM Layne-Central Co Cleveland, MS

P.O. Box 10631
Jackson, Mississippi 39209
WATER WELL DRILLERS LOG

NAME & MAILING ADDRESS OF LANDOWNER Eden Fisheries Rt 2 Box 79 YAZOO CITY, MS 39194			
WELL LOCATION:	SEC	TOWNSHIP	RANGE
	12	13	2
		N	W
DISTANCE	DIRECTION	NEAREST TOWN	
2 Miles	N	of Eden	
OTHER LANDMARK North Wells			
WELL PURPOSE: Hom. <input type="checkbox"/> Municipal <input type="checkbox"/> Industrial <input type="checkbox"/> Fish Pond <input checked="" type="checkbox"/> etc.			

PUMP DATA		
PUMP TYPE (Circle One): Submersible, <u>Turbine</u> , Jet, Flowing Well, Other (Describe) _____		
POWER TYPE (Circle One): Electric, Tractor, <u>Diesel</u> , Gasoline, Butane, Other (Describe) _____ H/P _____		
Pump Capacity (GPM) 1800	No. of Stages 1	Setting Depth 60 FT.
PUMP TEST Well yielded NOT TESTED GPM with a drawdown of _____ ft. after _____ hours of pumping		

WELL DATA		
Well Depth 114'6"	Casing Diameter (In.) 16	Casing Length (Ft.) 74'6"
Type of Casing Steel	Hole Depth 115'	Depth to Static Water Level 17'
TYPE OF COMPLETION: (Circle One or More): <u>Gravel Packed</u> , Underreamed, Telescoped, Natural Development, Open Hole, Other (Describe) _____		
Top of Lap Pipe or Reduction in Casing N/A FEET IF TELESCOPED OR MORE THAN ONE SCREEN: USE BACK PAGE		

LOG DATA	
TYPE OF LOG RUN (Circle One): Electric, Gamma Ray, Density, Sonic, Neutron, Other (Describe) _____	
Name of Organization Running Log No Log Run	

SCREEN DATA		
Diameter - Inches 16	Length - Feet 40	Slot Size - Inches .050
Screen Type Steel		Depth to Bottom - Feet —


GEOLOGIC DATA (Office Use Only)			
Surface Elev.	Geologic Unit	Unit Thickness	Depth to Top
Subs. SWL	Date	Analysis	Aquifer Test
Driller's Remarks			

DESCRIPTION OF FORMATIONS ENCOUNTERED	FROM	TO	FORMATIONS (Continued)	FROM	TO
Clay	0	14	<div style="font-size: 2em; font-weight: bold; opacity: 0.5;">RECEIVED</div> <p style="font-size: 1.5em; margin-top: 10px;">MAY 08 1991</p> <p style="font-size: 0.8em; margin-top: 10px;">Bureau of Land & Water Resources</p>		
Clay	14	20			
Fine Sand	20	34			
Fine Sand	34	54			
Coarse Sand	54	74			
Coarse Sand + Pea Gravel	74	94			
Coarse Sand + Gravel	94	113			
Clay	113	115			

IF MORE SPACE IS NEEDED, USE BACK

If well telescopes please
sketch and show depths.

GROUND LEVEL

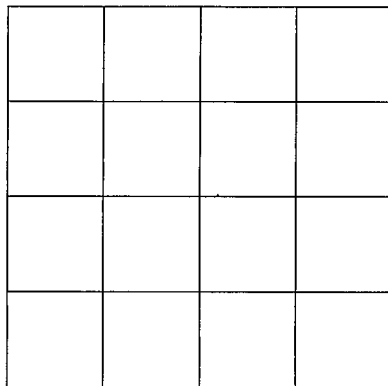

SECTION _____

Please indicate well location X.

ADDITIONAL INFORMATION

If more than one screen,
show location of each on sketch.