

YAZOO

OB

WATER WELL DRILLERS LOG

G

5-29-61

Date: 5/29, 1961, Driller: James McGee, County Yazoo (Name)

(1) Owner of Land: Joe R. Breadaway. (Name) Rt. 2, Box 77, Yazoo City, Miss. (Address)

(2) Location: 1/4, 1/4, Sec. 19 T13R14W, 3 miles East of Yazoo City (distance) (direction) (Nearest Town)

(3) Topography: X (Hilly) (Flat) (Level)

(4) Purpose of Well: Domestic. (Domestic Irrigation Municipal, Industrial, Other)

Table with 3 columns: Description & Color of Materials, Thickness Feet, Depth Feet. Rows include Clay & stks. gravel, Clay & stks. sand, Clay, Clay & sand, Mucky sand & rock, Fine sand, Clay & stks. sand, Clay, Clay & stks. sand, Sand & stks. clay, Fine sand.

Information upon completion of well:

(1) Diameter 2 inches.

(2) Total Depth 262 feet.

(3) Water Level 32' feet below top of ground.

(4) Cased to 252', Size 2"

(5) Screen: Size 2", Length 10'


(6) Were any formations sealed against pollution?

yes, X no.

If YES depth of formation

Why

Drillers Remarks: Good well.

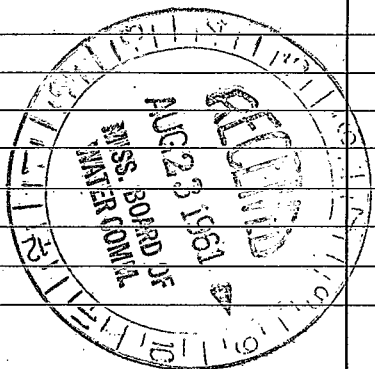

(Use Back Side)

Well No.

[The page contains several lines of extremely faint, illegible text, possibly bleed-through from the reverse side of the paper. The text is too light to transcribe accurately.]