

ELOG #199

MISSISSIPPI  
BOARD OF WATER COMMISSIONERS  
416 North State Street  
Jackson, Mississippi 39201

CODED

WATER WELL DRILLERS LOG

Nov. 21 1968  
date well completed

Bud Cresswell  
firm name

Yezoo  
county well located

LANDOWNER:

L.R. Parker  
Eden, Mississippi  
(mailing address)

description of formations encountered

from to

Clay	0	50
Sand - gravel	50	85
shale	85	120
Maudy Branch	120	140
shale, sdy - streaks	140	320
sand	320	430

WELL LOCATION:

sec. 19 T13 N R 1 E  
2 miles South of Eden  
(distance) (direction) (nearest town)

WELL PURPOSE: Domestic  
(home, irrigation, municipal, industrial)

WELL COMPLETION DATA:


- (1) diameter (inches) 2
- (2) total depth (feet) 430
- (3) static water level (feet) 220 below above top of ground.
- (4) casing 2" galv. pipe (material) (depth)  
2" if telescope see back. (size)
- (5) screen 20 410 (length) (depth to top)  
2" Stainless (size) (material)
- (6) pump (HP) (yield gpm)  
(type power)
- (7) electric log (yes or no)  
(organization running log)
- (8) how well bottom plugged

REC 25 1968  
MISS. DE. OF  
WATER COMM.

DRILLERS REMARKS:

If well telescopes please sketch and show depths.

GROUND LEVEL

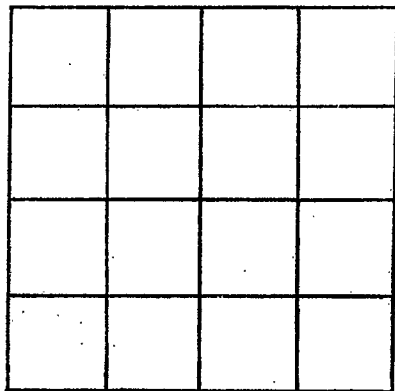

SECTION \_\_\_\_\_

Please indicate well location X.

ADDITIONAL INFORMATION

If more than one screen,  
show locations of each on sketch.