

YAZOO
B13
6-4-71

MISSISSIPPI
BOARD OF WATER COMMISSIONERS
416 North State Street
Jackson, Mississippi 39201

E LOG # 224

CODED

WATER WELL DRILLERS LOG

June 4 1971 E.M. "Bud" Cassard Yazoo
date well completed firm name county well located

LANDOWNER:

V. O. Russell

Eden, Miss.
(mailing address)

description of formations encountered

from

to

Clay	0	60
sand	60	85
shale	85	280
sand	280	385
sand - shale	385	446

WELL LOCATION:

sec. 11 T. 13 N R. 1 E
3 miles East of Eden
(distance) (direction) (nearest town)

WELL PURPOSE: livestock
(home, irrigation, municipal, industrial)

WELL COMPLETION DATA:

(1) diameter (inches) 4 X 2
(2) total depth (feet) 446
(3) static water level (feet) 85 below above top of ground.

(4) casing Steel, 3 1/2
(material) (depth)

4 if telescope see back.
(size)

(5) screen 30', 350
(length) (depth to top)
2", stainless steel
(size) (material)

(6) pump 1 1/2, 20
(HP) (yield gpm)

0
(type power)

(7) electric log yes
(yes or no)

State
(organization running log)

(8) how well bottom plugged
plug plug

CODED


JUL 6 1971

MISS. BD. OF
WATER COMM.

DRILLERS REMARKS:

If well telescopes please
sketch and show depths.

GROUND LEVEL

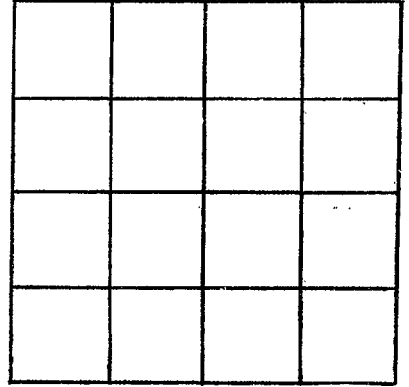

SECTION _____

Please indicate well location X.

ADDITIONAL INFORMATION

If more than one screen,
show locations of each on sketch.