

Yazoo
B 15
7-16-70

MISSISSIPPI
BOARD OF WATER COMMISSIONERS
416 North State Street
Jackson, Mississippi 39201

WATER WELL DRILLERS LOG

CODED

July 16 1970 E.M. "Bud" Cresswell Yazoo
date well completed firm name county well located

LANDOWNER:	description of formations encountered	from	to
JAMES SHARKEY Lexington, Miss. (mailing address)			
WELL LOCATION: sec. 11 T. 130 R. 1 4 miles E of Eden (distance) (direction) (nearest town)			
WELL PURPOSE: DOMESTIC (home, irrigation, municipal, industrial)			
WELL COMPLETION DATA:			
(1) diameter (inches) 2			
(2) total depth (feet) 380			
(3) static water level (feet) 130 below top of ground.			
(4) casing galv. 360 (material) (depth)			
2 (size) If telescope see back.			
(5) screen 20 360 (length) (depth to top)			
2 Stainless (size) (material)			
(6) pump None 0 (HP) (yield gpm)			
0 (type power)			
(7) electric log 0 (yes or no)			
0 (organization running log)			
(8) how well bottom plugged Steel plug			
DRILLERS REMARKS:			


CODED

JUL 21 1970

MISS. RD. OF
WATER COMMISSIONERS

If well telescopes please sketch and show depths.

GROUND LEVEL

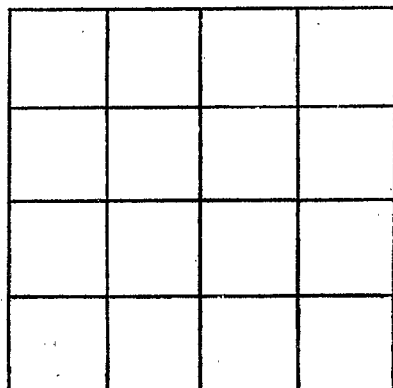

SECTION _____

Please indicate well location X.

ADDITIONAL INFORMATION

If more than one screen,
show locations of each on sketch.