

~~YAZOO~~
B 17
 5-29-61

WATER WELL DRILLERS LOG

CODED

Forest Drilling

Date: 5/29, 1961, Driller: James McGee County Yazoo

3885 7525

(Name)

(1) Owner of Land: Joe R. Broadway
 (Name)

Rt. 2, Box 77, Yazoo City, Miss.
 (Address)

Located about 5 miles East of
 (2) Location: 1/4, 1/4, Sec. 19 13 1W
Yazoo City on Hwy. 49 East.

 miles of
 (distance) (direction) (Nearest Town)

(3) Topography: X
 (Hilly) (Flat) (Level)

(4) Purpose of Well: Domestic.
 (Domestic Irrigation
 Municipal, Industrial, Other)

Information upon completion of well:

- (1) Diameter 2 inches.
- (2) Total Depth 262 feet.
- (3) Water Level 32 feet below top of ground.
- (4) Cased to 252', Size 2"
- (5) Screen: Size 2", Length 10'
- (6) Were any formations sealed against pollution?
 yes, X no.


If YES depth of formation

Why

Drillers Remarks: Good well.

Description & Color of Materials Sand, Clay, Red Clay, Shell, etc.	Thick- ness Feet	Depth Feet
Clay & stks. gravel.	0-	22
Clay & stks. sand.	22-	32
Clay.	32-	42
Clay & sand.	42-	92
Mucky sand & rock.	92-	112
Fine sand.	112-	118
Clay & stks. sand.	118-	132
Clay.	132-	212
Clay & stks. sand;	212-	222
Fine sand & stks. clay.	222-	232
Fine sand.	232-	242
Fair sand. (Screen set)	242-	262

CODED

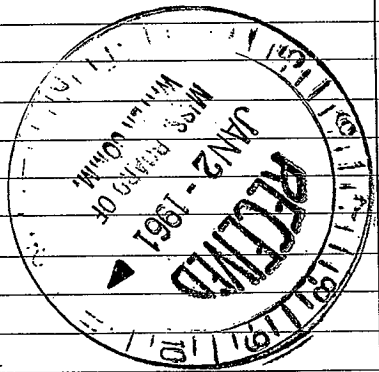

(Use Back Side)

Retain this copy for your office files.

Well

11