

YA200
B18
9-63

MISSISSIPPI BOARD OF WATER COMMISSIONERS

WATER WELL DRILLERS LOG **CODED**

Date: Sept., 1963, Driller: David Penny County Yazoo
(Name)

7464, 8248

(1) Owner of Land: D. H. Penn
(Name)
Eden, Miss.
(Address) 789 13 1W

(2) Location: 1/4, 1/4, Sec. T R
 miles North, of Eden
(distance) (direction) (Nearest Town)

(3) Topography: Flat
(Hilly) (Flat) (Level)

(4) Purpose of Well: Domestic
(Domestic Irrigation
Municipal, Industrial, Other)

Description & Color of Materials Sand, Clay, Red Clay, Shell, etc.	Thick- ness Feet	Depth Feet
<u>Clay</u>		<u>10</u>
<u>Sand</u>	<u>10</u>	<u>20</u>
<u>Sand</u>	<u>20</u>	<u>40</u>
<u>Sand</u>	<u>20</u>	<u>60</u>
<u>Sand</u>	<u>10</u>	<u>70</u>
<u>gravel</u>	<u>4</u>	<u>80</u>
<u>gravel</u>	<u>10</u>	<u>90</u>


Information upon completion of well:

- (1) Diameter 2 inches.
- (2) Total Depth 90 feet.
- (3) Water Level 22 feet below top of ground.
- (4) Cased to , Size .
- (5) Screen: Size 2" .010, Length 51.
- (6) Were any formations sealed against pollution?
 yes, no.

If YES depth of formation
Why

Drillers Remarks:

CODED

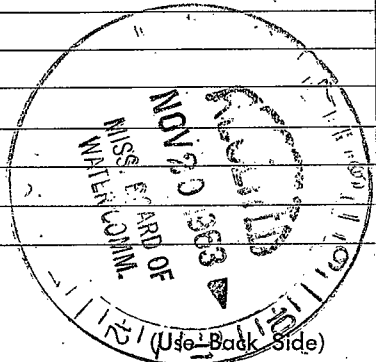

Well No.

Handwritten notes, possibly bleed-through from the reverse side of the page. The text is extremely faint and illegible.

Handwritten notes on the right side of the page, including the number "10" and some illegible characters.

