

YAZOO
B19
9-63

MISSISSIPPI BOARD OF WATER COMMISSIONERS

WATER WELL DRILLERS LOG

CODED

Date: Sept., 1963, Driller: DAVID BERRY County: YAZOO
(Name)

(1) Owner of Land: D. H. Dew
(Name)
Dew, Min
(Address) 289
T-13R1W

(2) Location: 1/4, 1/4, Sec. 13
1/4 miles West, of Edin
(distance) (direction) (Nearest Town)

(3) Topography: flat
(Hilly) (Flat) (Level)

(4) Purpose of Well: Domestic
(Domestic Irrigation
Municipal, Industrial, Other)

Description & Color of Materials Sand, Clay, Red Clay, Shell, etc.	Thick- ness Feet	Depth Feet
<u>clay</u>	<u>17</u>	<u>17</u>
<u>sand</u>	<u>3</u>	<u>20</u>
<u>sand</u>	<u>20</u>	<u>40</u>
<u>sand</u>	<u>20</u>	<u>60</u>
<u>sand</u>	<u>20</u>	<u>80</u>
<u>sand</u>	<u>12</u>	<u>92</u>
<u>gravel</u>	<u>8</u>	<u>100</u>

Information upon completion of well:

(1) Diameter 2 inches.

(2) Total Depth 100 feet.

(3) Water Level 22 feet below top of ground.

(4) Cased to _____, Size _____

(5) Screen: Size 1/10", Length 5'


(6) Were any formations sealed against pollution?
_____ yes, _____ no.

CODED

If YES depth of formation _____

Why _____

Drillers Remarks: _____

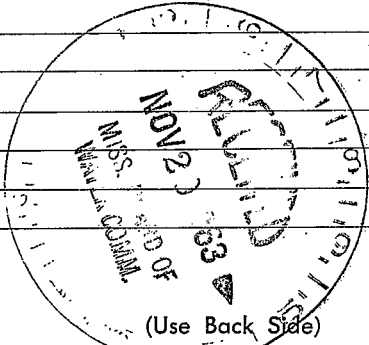

Well No.

