

Yazoo
B 20
5-7-66

MISSISSIPPI BOARD OF WATER COMMISSIONERS

WATER WELL DRILLERS LOG

CODED

Date: May 7, 1966, Driller: David Conway County Yazoo
2547 (Name)

(1) Owner of Land:	Description & Color of Materials Sand, Clay, Red Clay, Shell, etc.	Thick- ness Feet	Depth Feet
<u>R. H. Moore</u> (Name) <u>Edesa, Miss</u> (Address)	clay	18	18
(2) Location: <u>1/4</u> , <u>1/4</u> , Sec. <u>32</u> T <u>13</u> R <u>14</u> miles _____ of _____ (distance) (direction) (Nearest Town)	clay	20	38
(3) Topography: <u>flat</u> (Hilly) (Flat) (Level)	sandy clay	20	58
(4) Purpose of Well: <u>D</u> (Domestic Irrigation Municipal, Industrial, Other)	sandy clay	20	78
	sandy clay	20	98
	clay	20	118
	clay with sand holes	20	138
	clay with sand holes	20	158
	clay 13 ft. sand from 161 ft. to 173	20	178
	clay with sand sub.	20	198
	10 ft. solid sand with sub.	20	218
	at 230 ft. 6" rock	20	238
	clay 2' at 6" rock at 40	20	258
	sand	20	278
	clay with sand holes	20	298
	clay with sand	20	318
	clay with sand on bottom 10 ft.	20	338
	sand	20	358
	sand	20	378

Information upon completion of well:

(1) Diameter 4 1/2 inches.

(2) Total Depth 378 feet.

(3) Water Level _____ feet below top of ground.

(4) Cased to 368, Size 3 1/2 x 4", 4 1/2 x 2 1/2"

(5) Screen: Size 2", Length 10 1/2"


(6) Were any formations sealed against pollution?
_____ yes, _____ no.

If YES depth of formation _____

Why _____

Drillers Remarks: _____

CODED

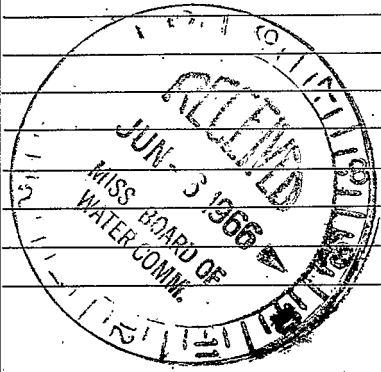

(Use Back Side)

Well No.

