

MISSISSIPPI DEPARTMENT OF NATURAL RESOURCES

Bureau of Land and Water Resources

Southport Mall

P.O. Box 10631

CODED

Jackson, Mississippi 39209

WATER WELL DRILLERS LOG

YAZOO
B 24
10/6/80

date well completed Oct. 6 1980 firm name E.M. "Bud" Cresswell county well located Yazoo

LANDOWNER:	description of formations encountered	from	to
<u>Charles Ables</u>			
<u>Yazoo City, Mo.</u> (mailing address)	<u>Sand</u>	<u>80</u>	<u>100</u>
WELL LOCATION:	<u>Clay</u>	<u>100</u>	<u>220</u>
sec. <u>32</u> T. <u>B</u> N R. <u>1</u> E	<u>Shale</u>	<u>220</u>	<u>340</u>
<u>4</u> miles <u>South</u> of <u>Eden</u>	<u>Sand, shale</u>	<u>340</u>	<u>600</u>
(distance) (direction) (nearest town)	<u>Shale</u>	<u>600</u>	<u>820</u>
WELL PURPOSE: <u>Home</u>	<u>Sand</u>	<u>820</u>	<u>960</u>
(home, irrigation, municipal, industrial)			
WELL COMPLETION DATA:			
(1) diameter (inches) <u>4</u>			
(2) total depth (feet) <u>960</u>			
(3) static water level (feet) <u>180</u> below top of ground.			
(4) casing <u>Steel</u> (material), <u>930</u> (depth)			
<u>4</u> (size) If telescope see back.			
(5) screen <u>30</u> (length), <u>930</u> (depth to top)			
<u>2</u> (size), <u>Stainless</u> (material)			
(6) pump <u>5</u> (HP), <u>50</u> (yield gpm)			
(type power)			
(7) electric log <u>No</u> (yes or no)			
(organization running log)			
(8) how well bottom plugged <u>back pressure valve</u>			
DRILLERS REMARKS:			


DEPT. OF NATURAL RESOURCES
BUREAU OF LAND & WATER RESOURCES

OCT 17 1980

RECEIVED

If well telescopes please sketch and show depths.

GROUND LEVEL

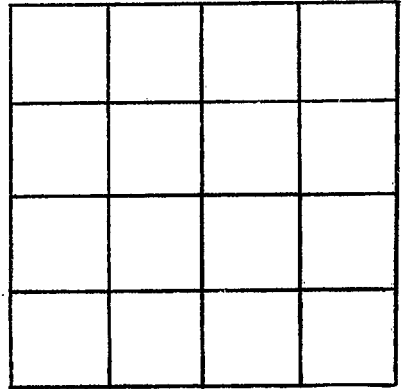

SECTION _____

Please indicate well location X.

ADDITIONAL INFORMATION

If more than one screen,
show locations of each on sketch.