

BOARD OF WATER COMMISSIONERS  
416 North State Street  
Jackson, Mississippi 39201

3248

Yazoo  
B25  
10-15-80


WATER WELL DRILLERS LOG

10/15 1980 Dyer Yozoo  
date well completed firm name county well located


LANDOWNER:	description of formations encountered	from	to
<u>DANNY DEW</u>	<del>fine sand</del> <u>medium sand</u>	<u>0</u>	<u>28</u>
<u>E DEW Mrs.</u> (mailing address)	<u>Clay</u>	<u>28</u>	<u>38</u>
<u>WELL LOCATION:</u> sec. <u>6</u> T. <u>130</u> N. R. <u>1</u> E. <u>W</u> <u>3</u> miles <u>N</u> of <u>EDON</u> (distance) (direction) (nearest town)	<u>medium sand</u>	<u>38</u>	<u>75</u>
<u>WELL PURPOSE:</u> (home, irrigation, municipal, industrial)	<u>Sand + Gravel</u>	<u>75</u>	<u>166</u>
<u>WELL COMPLETION DATA:</u>			
(1) diameter (inches) <u>12"</u>			
(2) total depth (feet) <u>166'</u>			
(3) static water level (feet) <u>22'</u> below above top of ground.			
(4) casing <u>Steel</u> <u>106'</u> (material) (depth)			
<u>12"</u> If telescope see back. (size)			
(5) screen <u>40'</u> <u>66'</u> (length) (depth to top)			
<u>12"</u> <u>Steel</u> (size) (material)			
(6) pump <u>40</u> <u>2000</u> (HP) (yield gpm)			
<u>electric</u> (type power)			
(7) electric log <u>                    </u> (yes or no)			
<u>                    </u> (organization running log)			
(8) how well bottom plugged <u>plate</u>			

**CODED**

**CODED**

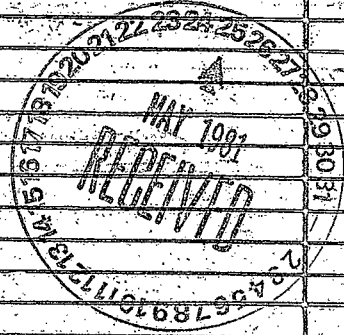

DRILLERS REMARKS:

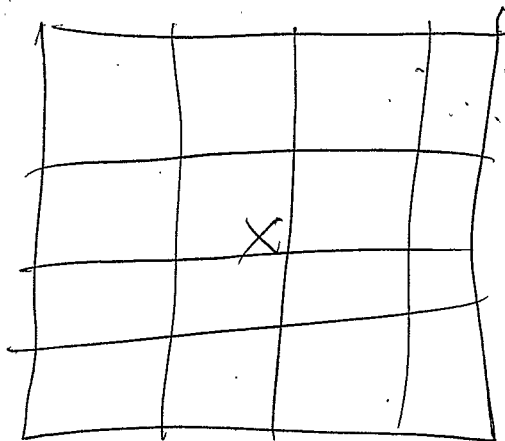

sec 6

---