

MISSISSIPPI DEPARTMENT OF NATURAL RESOURCES

Bureau of Land and Water Resources

Southport Mall

P.O. Box 10631

Jackson, Mississippi 39209

WATER WELL DRILLERS LOG

CODED

YAZOO
B105

July 28 1984
date well completed

E.M. Fred CRESSWELL
firm name

Yazoo
county well located

LANDOWNER:
Ed New
Yazoo City, Ms. 39194
(mailing address)

description of formations encountered	from	to
	Clay	0
Sand-gravel	40	85
Sandy Shell	85	220
Sand	220	410
Shale	410	660
Sand	660	730

WELL LOCATION:
sec. 4 T. 13 N R. 1 E
2 miles North of Eden
(distance) (direction) (nearest town)

WELL PURPOSE: Farm
(home, irrigation, municipal, industrial)

WELL COMPLETION DATA:

(1) diameter (inches) 4

(2) total depth (feet) 730

(3) static water level (feet) 12 below top of ground.

(4) casing Steel 690 (material), (depth)
4 (size) if telescope see back.

(5) screen 40 690 (length), (depth to top)
2 Stainless (size), (material)

(6) pump 2 45 (HP), (yield gpm)
(type power)

(7) electric log No (yes or no)
(organization running log)

(8) how well bottom plugged
back wash valve

DRILLERS REMARKS:

CODED


DEPT. OF NATURAL RESOURCES
BUREAU OF LAND & WATER RESOURCES

AUG 7 1984

RECEIVED

If well telescopes please sketch and show depths.

GROUND LEVEL

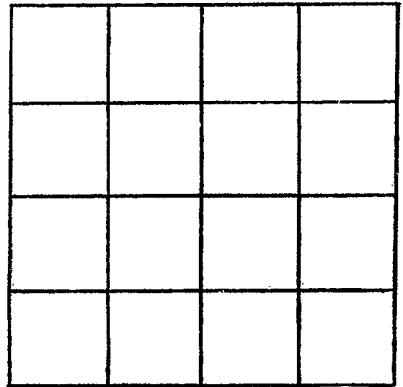

SECTION _____

Please indicate well location X.

ADDITIONAL INFORMATION

If more than one screen, show locations of each on sketch.