

MISSISSIPPI DEPARTMENT OF NATURAL RESOURCES

Bureau of Land and Water Resources

Southport Mall

P.O. Box 10631

Jackson, Mississippi 39209

WATER WELL DRILLERS LOG

CODED

YAZOO
B 106
3-21-86

3-21 1986 E.M. Bud Crosswell YAZOO
 date well completed firm name county well located

LANDOWNER: A.E. Edjar III
 Eden, Ms.
 (mailing address)

description of formations encountered	from	to
surface	0	65
sand-gravel	65	85
low shale	85	285
sandy shale	285	380
sand	380	475
shale	475	820
sand	820	860
shale	860	900
sand	900	1060
shale	1060	1080

WELL LOCATION:
 sec. 20 T 13 N R. 1 E
 2 miles South of Eden
 (distance) (direction) (nearest town)

WELL PURPOSE: farm
 (home, irrigation, municipal, industrial)

WELL COMPLETION DATA:

(1) diameter (inches) 4

(2) total depth (feet) 1080

(3) static water level (feet) 195 below top of ground.

(4) casing Steel 1020
 (material) (depth)
 4 (size) if telescope see back.

(5) screen 40 1020
 (length) (depth to top)
 2 STAINLESS
 (size) (material)


(6) pump 3 40
 (HP) (yield gpm)

(type power)

(7) electric log no
 (yes or no)

(organization running log)


(8) how well bottom plugged Back wash

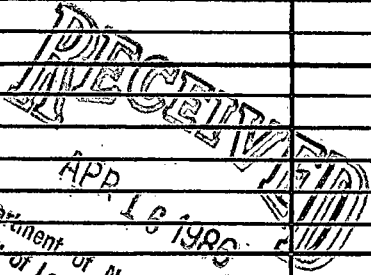

DRILLERS REMARKS:

If well telescopes please sketch and show depths.

GROUND LEVEL

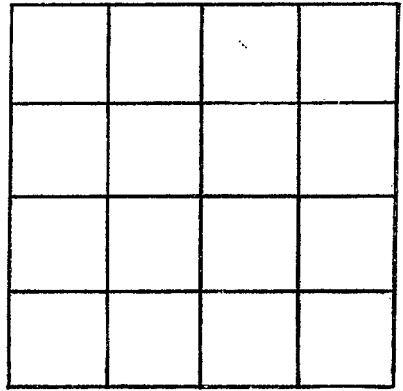

SECTION _____

Please indicate well location X.

ADDITIONAL INFORMATION

If more than one screen,
show locations of each on sketch.