

YAZOO  
 B 200  
 428-78

MISSISSIPPI  
 BOARD OF WATER COMMISSIONERS  
 416 North State Street  
 Jackson, Mississippi 39201

WATER WELL DRILLERS LOG

4-28 date well completed      1978 E.M. "Bud" Cresswell firm name      Yazoo county well located

LANDOWNER:  
 Danny Dew  
 Eden, MS.  
 (mailing address)

description of formations encountered	from	to
Clay	0	25
Sand & gravel	25	95

WELL LOCATION:  
 sec. 5 T. 13 N. R. 1 E.  
 1 miles North of Eden  
 (distance) (direction) (nearest town)

WELL PURPOSE: farm  
 (home, irrigation, municipal, industrial)

WELL COMPLETION DATA:

(1) diameter (inches) 4

(2) total depth (feet) 95

(3) static water level (feet) 20 below top of ground.

(4) casing PVC, 85 (material), (depth)  
 4 (size) if telescope see back.

(5) screen 10, 85 (length), (depth to top)  
 4, PVC (size), (material)

(6) pump 1, 30 (HP), (yield gpm)  
 0 (type power)

(7) electric log No (yes or no)  
 0 (organization running log)

(8) how well bottom plugged  
 Duck wash valve


DRILLERS REMARKS:

RECEIVED  
 MAY 3 - 1978

MISS. BD. OF WATER COMM.

If well telescopes please sketch and show depths.

GROUND LEVEL

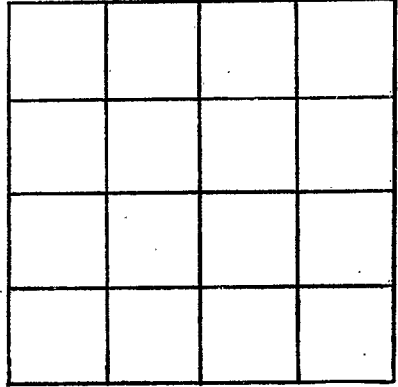

SECTION \_\_\_\_\_

Please indicate well location X.

ADDITIONAL INFORMATION

If more than one screen, show locations of each on sketch.