

MISSISSIPPI DEPARTMENT OF NATURAL RESOURCES

Bureau of Land and Water Resources

Southport Mall

P.O. Box 10631

Jackson, Mississippi 39209

WATER WELL DRILLERS LOG

Yazoo
B2003

Feb. 26 1982 E.M. "Bud" Cresswell Yazoo
date well completed firm name county well located

LANDOWNER:	description of formations encountered	from	to
Mr. J. P. Parker			
Eden, MS. (mailing address)	Clay	0	30
WELL LOCATION:	Sand-gravel	30	120
sec. <u>9</u> T. <u>13</u> N. R. <u>1</u> W.			
<u>1</u> miles <u>North</u> of <u>Eden</u> (distance) (direction) (nearest town)			
WELL PURPOSE: <u>Home</u> (home, irrigation, municipal, industrial)			
WELL COMPLETION DATA:			
(1) diameter (inches) <u>2</u>			
(2) total depth (feet) <u>120</u>			
(3) static water level (feet) <u>20</u> below top of ground.			
(4) casing <u>Pvc</u> , <u>110</u> (material) (depth)			
<u>2</u> if telescope see back. (size)			
(5) screen <u>10</u> , <u>110</u> (length) (depth to top)			
<u>2</u> , <u>Pvc</u> (size) (material)			
(6) pump <u>1</u> , <u>10</u> (HP) (yield gpm)			
(type power) <u>No</u>			
(7) electric log <u>No</u> (yes or no)			
(organization running log)			
(8) how well bottom plugged <u>back with valve</u>			
DRILLERS REMARKS:			


DEPT. OF NATURAL RESOURCES
BUREAU OF LAND & WATER RESOURCES

MAR 26 1982

RECEIVED

If well telescopes please
sketch and show depths.

GROUND LEVEL

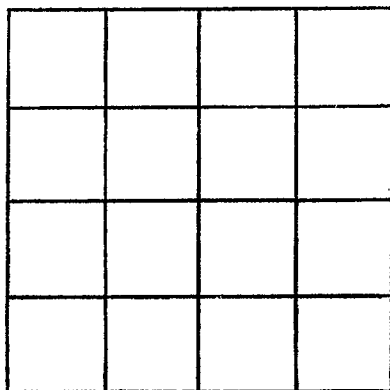

SECTION _____

Please indicate well location X.

ADDITIONAL INFORMATION

If more than one screen,
show locations of each on sketch.