

MISSISSIPPI DEPARTMENT OF NATURAL RESOURCES

Bureau of Land and Water Resources

Southport Mall

P.O. Box 10631

Jackson, Mississippi 39209

WATER WELL DRILLERS LOG

Yazoo
B 2004
5-26-83


May 26 1983 E.M. "Bud" CRESSWELL YAZOO
 date well completed firm name county well located

LANDOWNER:	description of formations encountered	from	to
<u>HOWARD HISAW</u>			
<u>YAZOO City, MS.</u> (mailing address)	<u>Clay -</u>	<u>0</u>	<u>260</u>
	<u>Sand - fine</u>	<u>260</u>	<u>340</u>
	<u>Sand - good</u>	<u>340</u>	<u>440</u>
WELL LOCATION:			
sec. <u>32</u> T <u>13</u> N R <u>1</u> E			
<u>4</u> miles <u>South</u> of <u>Eden</u>			
(distance) (direction) (nearest town)			
WELL PURPOSE: <u>Home</u>			
(home, irrigation, municipal, industrial)			
WELL COMPLETION DATA:			
(1) diameter (inches) <u>2</u>			
(2) total depth (feet) <u>440</u>			
(3) static water level (feet) <u>210</u> below top of ground.			
(4) casing <u>PVC</u> <u>400</u>			
(material) (depth)			
<u>2</u> if telescope see back.			
(size)			
(5) screen <u>40</u> <u>400</u>			
(length) (depth to top)			
<u>2</u> <u>PVC</u>			
(size) (material)			
(6) pump <u>Air Compressor</u>			
(HP) (yield gpm)			
(type power)			
(7) electric log <u>no</u>			
(yes or no)			
(organization running log)			
(8) how well bottom plugged <u>check wash value</u>			

DRILLERS REMARKS:

If well telescopes please sketch and show depths.

GROUND LEVEL

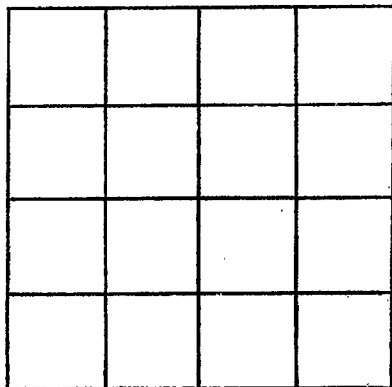

SECTION _____

Please indicate well location X.

ADDITIONAL INFORMATION

If more than one screen, show locations of each on sketch.