

MISSISSIPPI DEPARTMENT OF NATURAL RESOURCES

Bureau of Land and Water Resources

Southport Mall

P.O. Box 10631

Jackson, Mississippi 39209

WATER WELL DRILLERS LOG

CODED

VAZOO
B2005
8/29/83

Aug. 29, 1983 date well completed
DYER WELL + IRRIGATION firm name
VAZOO county well located

LANDOWNER: DANNY DEW
Eden, Miss (mailing address)
WELL LOCATION:
sec. 16 T12N R11W S
1 miles SE of Eden, Ms.
(distance) (direction) (nearest town)

description of formations encountered	from	to
<u>Clay</u>	<u>0</u>	<u>45</u>
<u>Sand + Gravel + Clay</u>	<u>45</u>	<u>95</u>
<u>Fine Sand</u>	<u>95</u>	<u>106</u>
	<u>106</u>	<u>118</u>
	<u>-</u>	<u>-</u>

WELL PURPOSE: IRRIGATION
(home, irrigation, municipal, industrial)

CODED

WELL COMPLETION DATA:

(1) diameter (inches) 16

(2) total depth (feet) 104

(3) static water level (feet) 22 below top of ground.

(4) casing Steel (material), (depth) 16 (size) if telescope see back.

(5) screen 40 (length), (depth to top) 16" (size), Mild Steel (material)

(6) pump 600 (HP), 3,000 (yield gpm)
Electric (type power)

(7) electric log No (yes or no)
(organization running log)

(8) how well bottom plugged Plate

DEPT. OF NATURAL RESOURCES
BUREAU OF LAND & WATER RESOURCES

NOV 28 1983


RECEIVED

DRILLERS REMARKS:

2

If well telescopes please sketch and show depths.

GROUND LEVEL

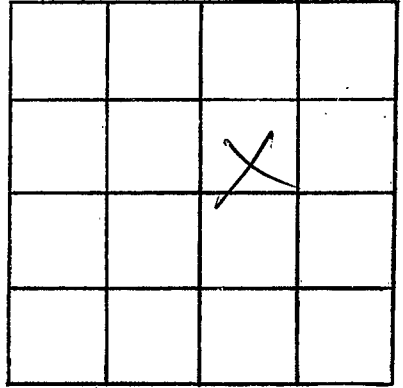

SECTION _____

Please indicate well location X.

ADDITIONAL INFORMATION

If more than one screen,
show locations of each on sketch.