

Yazoo
~~*Holmes*~~
 B. 2000

MISSISSIPPI
 BOARD OF WATER COMMISSIONERS
 416 North State Street
 Jackson, Mississippi 39201

WATER WELL DRILLERS LOG

Yazoo
~~*Holmes*~~
 June 13 1983 E.M. "Bud" CRESSWELL
 date well completed firm name county well located

LANDOWNER:
Dudley F. Phelps III
JACKSON, MS.
 (mailing address)

description of formations encountered	from	to
<i>Sand</i>	<i>0</i>	<i>40</i>
<i>Sand - Sandy Shale</i>	<i>40</i>	<i>190</i>
<i>Sand</i>	<i>190</i>	<i>210</i>

WELL LOCATION:
 sec. *19* T. *13* N R. *7* E
3 miles *West* of *Eden*
 (distance) (direction) (nearest town)

WELL PURPOSE: *None*
 (home, irrigation, municipal, industrial)

- WELL COMPLETION DATA:
- (1) diameter (inches) *4*
 - (2) total depth (feet) *210*
 - (3) static water level (feet) *120* below top of ground.
 - (4) casing *PVC 200*
 (material) (depth)
4 if telescope see back.
 (size)
 - (5) screen *10 200*
 (length) (depth to top)
4 PVC
 (size) (material)
 - (6) pump *1 10*
 (HP) (yield gpm)
 - (type power)
 - (7) electric log *No*
 (yes or no)
 - (organization running log)

(8) how well bottom plugged
Backwash

DRILLERS REMARKS:


DEPT. OF NATURAL RESOURCES
 BUREAU OF LAND & WATER RESOURCES

JUN 30 1983

RECEIVED

If well telescopes please sketch and show depths.

GROUND LEVEL

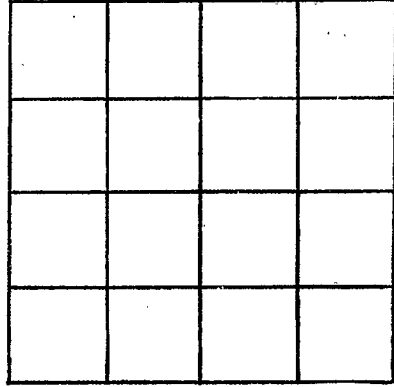

SECTION _____

Please indicate well location X.

ADDITIONAL INFORMATION

If more than one screen, show locations of each on sketch.