

MISSISSIPPI DEPARTMENT OF NATURAL RESOURCES

Bureau of Land and Water Resources

Southport Mall

P.O. Box 10631

Jackson, Mississippi 39209

WATER WELL DRILLERS LOG

44200
B2007

Nov. 19 1983 E.M. Bud "Cresswell" 44200
date well completed firm name county well located


LANDOWNER:	description of formations encountered	from	to
JACK Landrum			
BENTONIA MS. 39040 (mailing address)	Clay Sand	0	12 52
WELL LOCATION:			
sec. 15 T. 13 N. R. 1 W. 10 miles EAST of Benton			
WELL PURPOSE: farm (home, irrigation, municipal, industrial)			
WELL COMPLETION DATA:			
(1) diameter (inches) 2			
(2) total depth (feet) 52			
(3) static water level (feet) 15 below top of ground.			
(4) casing PVC 42 (material) (depth)			
2 (size) if telescope see back.			
(5) screen 10 42 (length) (depth to top)			
2 PVC (material)			
(6) pump 1 10 (HP) (yield gpm)			
(type power)			
(7) electric log No- (yes or no)			
(organization running log)			
(8) How well bottom plugged fair wash			

DEPT. OF NATURAL RESOURCES
BUREAU OF LAND & WATER RESOURCES
JAN 5 - 1984
RECEIVED

DRILLERS REMARKS:

If well telescopes please sketch and show depths.

GROUND LEVEL

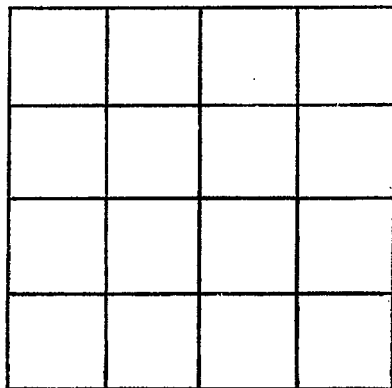

SECTION _____

Please indicate well location X.

ADDITIONAL INFORMATION

If more than one screen,
show locations of each on sketch.