

MISSISSIPPI DEPARTMENT OF NATURAL RESOURCES

Bureau of Land and Water Resources

Southport Mall

P.O. Box 10631

Jackson, Mississippi 39209

WATER WELL DRILLERS LOG

Y 200
B 2008

May 14
date well completed

86 E.M. Bud Cresswell
firm name

Y 200
county well located

LANDOWNER:
Danny Dew
Eden, MS.
(mailing address)

description of formations encountered	from	to
Surface	0	25
Bank gravel	25	110

WELL LOCATION:
sec. 7 T. 13 N. R. 1 W.
Eden
miles of (nearest town)

WELL PURPOSE: farm
(home, irrigation, municipal, industrial)

WELL COMPLETION DATA:

(1) diameter (inches) 4

(2) total depth (feet) 110

(3) static water level (feet) 12 below top of ground.

(4) casing PVC 90
(material) (depth)

4 if telescope see back.
(size)

(5) screen 30 90
(length) (depth to top)

4 PVC
(size) (material)


(6) pump 1 25
(HP) (yield gpm)

(type power)

(7) electric log No
(yes or no)

(organization running log)

(8) How well bottom plugged
Back wash

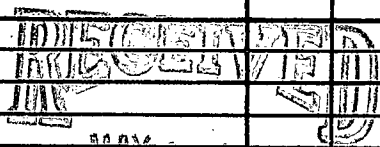


Department of Natural Resources
Bureau of Land & Water

DRILLERS REMARKS:

If well telescopes please sketch and show depths.

GROUND LEVEL

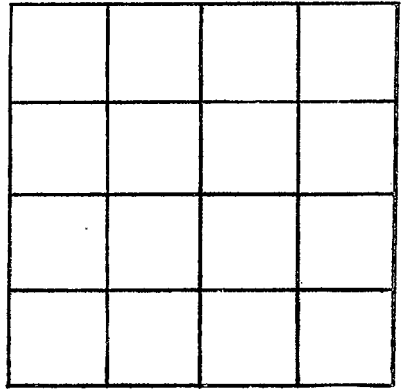

SECTION _____

Please indicate well location X.

ADDITIONAL INFORMATION

If more than one screen,
show locations of each on sketch.