

MISSISSIPPI DEPARTMENT OF NATURAL RESOURCES

Bureau of Land and Water Resources

Southport Mall

P.O. Box 10631

Jackson, Mississippi 39209

WATER WELL DRILLERS LOG

VAJ 00  
B 5000

6-20 1989 F. D. Conway VAJ 00  
 date well completed firm name county well located

LANDOWNER: <u>Mr. Parker</u> (mailing address)	Description of formations encountered	from	to
		<u>Top soil</u>	<u>0</u>
	<u>Fine sand</u>	<u>8</u>	<u>20</u>
	<u>Coarse sand</u>	<u>20</u>	<u>37</u>

WELL LOCATION:  
 sec. 14 T13N R1E  
8 miles N of VAJ 00 City  
 (distance) (direction) (nearest town)

WELL PURPOSE:  
 home irrigation,  municipal,  industrial

- WELL COMPLETION DATA:
- (1) diameter (inches) 2"
  - (2) total depth (feet) 56'
  - (3) static water level (feet) 48' below top of ground.
  - (4) casing 2" (material) 56' (depth)  
2" (size) if telescope see back.
  - (5) screen 2" (length) 56' (depth to top)  
2x10 p.v.c. (size) (material)
  - (6) pump 1 (HP) 220 (yield gpm)  
Elec. (type power)
  - (7) electric log no (yes or no)  
Sand block (organization running log)
  - (8) how well bottom plugged \_\_\_\_\_


DRILLERS REMARKS:

RECEIVED  
 JUL 05 1989

Department of Natural Resources  
 Bureau of Land & Water Resources

If well telescopes please  
sketch and show depths.

GROUND LEVEL

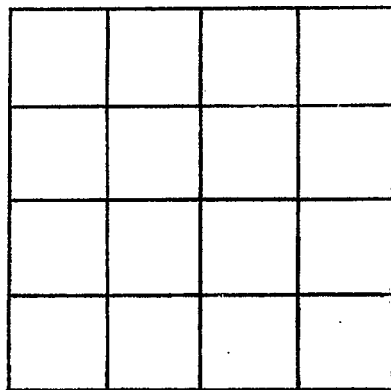

SECTION \_\_\_\_\_

Please indicate well location X.

ADDITIONAL INFORMATION

If more than one screen,  
show locations of each on sketch.