

YA200
C
11-65

WATER WELL DRILLERS LOG

Date: Nov, 1965, Driller: W Kay County: Yazoo
Name

(1) Owner of Land: Mrs Walter
(Name)
Benton Miss
(Address)

(2) Location: 1/4, 1/4, Sec. T R,
_____ miles _____ of Meru
(distance) (direction) (Nearest town)

(3) Topography: _____
(Hilly) (Flat) (Level)

(4) Purpose of Well: Home
(Domestic Irrigation
Municipal, Industrial, Other)

Description & Color of Materials Sand, Clay, Red Clay, Shell, etc.	Thick- ness Feet	Depth Feet
<u>Red Clay</u>	<u>0</u>	<u>20</u>
<u>White Clay</u>	<u>20</u>	<u>40</u>
<u>Blue Clay</u>	<u>40</u>	<u>60</u>
<u>Blue Clay</u>	<u>60</u>	<u>240</u>
<u>Grey Clay</u>	<u>240</u>	<u>260</u>
<u>Blue Clay</u>	<u>260</u>	<u>320</u>
<u>Sandy Shale</u>	<u>320</u>	<u>340</u>
<u>Sandy Clay</u>	<u>340</u>	<u>420</u>
<u>Med Sand</u>	<u>420</u>	<u>480</u>

Information upon completion of well:

(1) Diameter 2 inches.

(2) Total Depth 480 feet.

(3) Water Level 27 feet below top of ground.


(4) Cased to _____, Size _____

(5) Screen: Size 007, Length 20

(6) Were any formations sealed against pollution?
_____ yes, ✓ no.

34 Pans

If YES depth of formation _____
Why _____
Drillers Remarks: _____

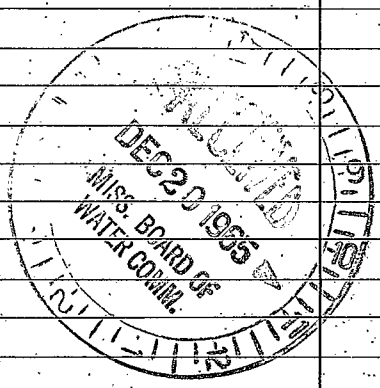

(Use Back Side)

Well No.

