

YA200

WATER WELL DRILLERS LOG

Date: July 8, 1965, Driller: M Kay County: Yazoo
7-8-65 (Name)

(1) Owner of Land: Mr. Pelim
(Name)
Benton
(Address)

(2) Location: 1/4, 1/4, Sec. T R
3 miles W, of Minway
(distance) (direction) (Nearest Town)

(3) Topography: (Hilly) (Flat) (Level)

(4) Purpose of Well: Home
(Domestic Irrigation, Municipal, Industrial, Other)

Description & Color of Materials Sand, Clay, Red Clay, Shell, etc.	Thick- ness Feet	Depth Feet
<u>Red Clay</u>	<u>0</u>	<u>20</u>
<u>Sand Clay</u>	<u>20</u>	<u>40</u>
<u>Red Sand</u>	<u>40</u>	<u>60</u>
<u>Blue Clay</u>	<u>60</u>	<u>80</u>
<u>Blue Clay</u>	<u>80</u>	<u>120</u>
<u>Sandy Shale</u>	<u>120</u>	<u>140</u>
<u>Rock</u>	<u>240</u>	<u>252</u>
<u>Shale</u>	<u>252</u>	<u>266</u>
<u>Shale</u>	<u>262</u>	<u>280</u>
<u>Fine Sand</u>	<u>280</u>	<u>300</u>
<u>Sandy clay</u>	<u>300</u>	<u>340</u>
<u>Fine Sand</u>	<u>340</u>	<u>360</u>
<u>Med Sand</u>	<u>360</u>	<u>400</u>

Information upon completion of well:

(1) Diameter 2 inches.

(2) Total Depth 400 feet.

(3) Water Level 144 feet below top of ground.

(4) Cased to _____, Size _____

(5) Screen: Size 607, Length 20


(6) Were any formations sealed against pollution?
_____ yes, no.

3HP-230 air

If YES depth of formation _____

Why _____

Drillers Remarks: _____

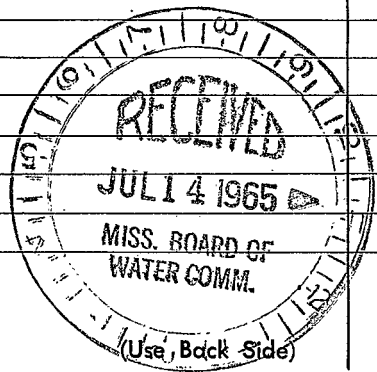

Well No.

