

YA200  
C  
5-63

Holmes?  
11

WATER WELL DRILLERS LOG

Date: May, 1963, Driller: David Berry County Yazoo  
(Name)


(1) Owner of Land: <u>James Hawthorn</u> (Name)	Description & Color of Materials Sand, Clay, Red Clay, Shell, etc.	Thick- ness Feet	Depth Feet
<u>Jackson, Miss</u> (Address)	<u>Clay</u>		<u>30</u>
(2) Location: <u>1/4</u> , <u>1/4</u> , Sec. <u>    </u> T <u>    </u> R <u>    </u>	<u>Sandy Clay</u>	<u>20</u>	<u>50</u>
<u>1</u> miles <u>North</u> , of <u>Prater</u> (distance) (direction) (Nearest Town)	<u>Hard Clay</u>	<u>65</u>	<u>115</u>
(3) Topography: <u>Hilly</u> (Hilly) (Flat) (Level)	<u>Rock</u>	<u>1</u>	<u>116</u>
(4) Purpose of Well: <u>Domestic</u> (Domestic Irrigation Municipal, Industrial, Other)	<u>Sandy Clay</u>	<u>44</u>	<u>150</u>
	<u>Sand</u>	<u>92</u>	<u>242</u>
	<u>Clay</u>	<u>2</u>	<u>242</u>
	<u>Sand</u>	<u>11</u>	<u>255</u>

Information upon completion of well:

- (1) Diameter 2 inches.
- (2) Total Depth 255 feet.
- (3) Water Level 102' feet below top of ground.
- (4) Cased to \_\_\_\_\_, Size \_\_\_\_\_
- (5) Screen: Size 2", Length 5'  
.010
- (6) Were any formations sealed against pollution?  
\_\_\_\_\_ yes, \_\_\_\_\_ no.

If YES depth of formation \_\_\_\_\_  
Why \_\_\_\_\_

Drillers Remarks: \_\_\_\_\_  
\_\_\_\_\_  
\_\_\_\_\_

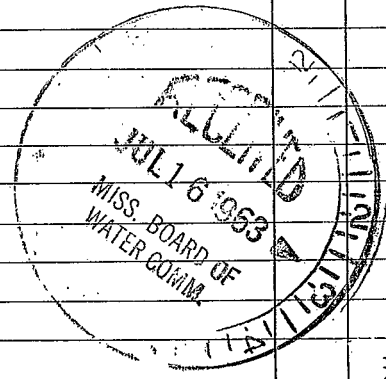

(Use Back Side)

Well No.

