

YA200  
CZ1  
12-29-64

MISSISSIPPI BOARD OF WATER COMMISSIONERS

WATER WELL DRILLERS LOG

CODED  
*sec. 7-12-25*

Date: 12/29, 1964, Driller: McKary County: Yazoo  
6293 6293 (Name)

(1) Owner of Land: W.C. King  
(Name)  
RT 2 Benton  
(Address)

(2) Location: 1/4, 1/4, Sec. 11 T2 R1 E  
10 miles NE of Benton  
(distance) (direction) (Nearest Town)

(3) Topography:  (Hilly)  (Flat)  (Level)

(4) Purpose of Well: Home  
(Domestic Irrigation  
Municipal, Industrial, Other)

Description & Color of Materials Sand, Clay, Red Clay, Shell, etc.	Thick- ness Feet	Depth Feet
<u>Red clay</u>	<u>0</u>	<u>20</u>
<u>Blue clay</u>	<u>20</u>	<u>40</u>
<u>Blue clay</u>	<u>40</u>	<u>140</u>
<u>Sandy shale</u>	<u>140</u>	<u>160</u>
<u>100 "</u>	<u>160</u>	<u>180</u>
<u>Brown shale</u>	<u>180</u>	<u>230</u>
<u>med to fine sand</u>	<u>230</u>	<u>300</u>
<u>med to fine sand</u>	<u>300</u>	<u>320</u>

Information upon completion of well:

(1) Diameter 4x2 inches.

(2) Total Depth 320 feet.

(3) Water Level 80 feet below top of ground.

(4) Cased to 147, Size 4"

(5) Screen: Size 007, Length 20


(6) Were any formations sealed against pollution?  
no.

CODED

Set 1/2 inch Franklin  
Pump 136ft Deep  
1" Dray Pipe

If YES depth of formation \_\_\_\_\_  
Why \_\_\_\_\_

Drillers Remarks: \_\_\_\_\_

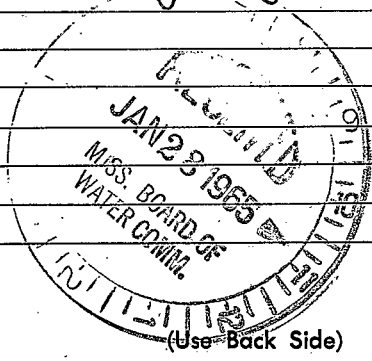

Well No. \_\_\_\_\_

