

MISSISSIPPI
BOARD OF WATER COMMISSIONERS
416 North State Street
Jackson, Mississippi 39201

CODED

WATER WELL DRILLERS LOG

Yazoo
C 22
6-20-70

6-20 1970 E. M. "Bud" Cresswell Yazoo
date well completed firm name county well located

LANDOWNER:

Herbert G. WATTS
Vaughn, Miss-
(mailing address)

description of formations encountered

	from	to
Clay - yellow	0	30
Shale	30	200
Sdy shale	200	320
Sand	320	440

WELL LOCATION:

sec 16 T 12 N R 1 E
4 miles West of Vaughn
(distance) (direction) (nearest town)

WELL PURPOSE: Domestic
(home, irrigation, municipal, industrial)

WELL COMPLETION DATA:

- (1) diameter (inches) 2
- (2) total depth (feet) 440
- (3) static water level (feet) 120 below top of ground.
- (4) casing Steel, 430 (material) (depth)
- 2 (size) If telescope see back.
- (5) screen 10 430 (length) (depth to top)
- 2, Stainless (size) (material)
- (6) pump Air Compressor (HP) (del. gpm)
- 0 (type power)
- (7) electric log No (yes or no)
- 0 (organization running log)

CODE

- (8) how well bottom plugged Steel plug


DRILLERS REMARKS:

JUN 23 1970

MISS. BD. OF
WATER COMMISSIONERS

If well telescopes please
sketch and show depths.

GROUND LEVEL

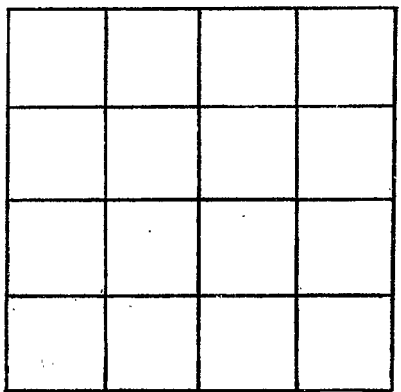

SECTION _____

Please indicate well location X.

ADDITIONAL INFORMATION

A series of horizontal lines for providing additional information.

If more than one screen,
show locations of each on sketch.