

MISSISSIPPI DEPARTMENT OF NATURAL RESOURCES

Bureau of Land and Water Resources

Southport Mall

P.O. Box 10631

CODED

Jackson, Mississippi 39209

WATER WELL DRILLERS LOG

Griner Drilling Service, Inc.

Yazoo

20300
C 25
10-15-81

10-15-81 date well completed

Griner Drilling Service, Inc. firm name

Yazoo county well located

LANDOWNER:
Parco Drilling
P.O. Box 873
Natchez, MS 39120
(mailing address)

| description of formations encountered | from | to |
|---------------------------------------|------|-----|
| Fill dirt + chalk | 0 | 21 |
| chalk, rock, sand | 21 | 315 |
| sand | 315 | 378 |
| chalk | 378 | 420 |

WELL LOCATION: 1650' S + 2100' W
sec. 14 T. 12 R. 1 E of
Pickens NE/4
1-14 miles (direction) of (nearest town)

WELL PURPOSE: oil field supply
(home, irrigation, municipal, industrial)

WELL COMPLETION DATA:

(1) diameter (inches) 3"

(2) total depth (feet) 420'

(3) static water level (feet) 80' below top of ground.

(4) casing steel, 378' (material), (depth)
3" (size) if telescope see back.

(5) screen 42' (length), 336' (depth to top)
3" (size), perforated (material)

(6) pump — (HP), 75 (yield gpm)
AC (type power)

(7) electric log — (yes or no)
(organization running log)

CODED

(8) how well bottom plugged orange peel


DRILLERS REMARKS:

DEPT. OF NATURAL RESOURCES
BUREAU OF LAND & WATER RESOURCES

OCT 20 1981
RECEIVED

If well telescopes please sketch and show depths.

GROUND LEVEL

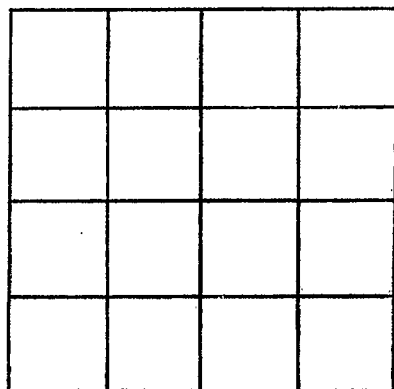

SECTION _____

Please indicate well location X.

ADDITIONAL INFORMATION

If more than one screen,
show locations of each on sketch.