

MISSISSIPPI DEPARTMENT OF NATURAL RESOURCES

Bureau of Land and Water Resources

Southport Mall

P.O. Box 10631

Jackson, Mississippi 39209

WATER WELL DRILLERS LOG

CODED

Y 200  
C 28

JAN. 15 1986 E.M. Bud CRESSWELL Y 200  
date well completed firm name county well located

LANDOWNER:  
Energy Drilling Co.  
Natchez, Ms.  
(mailing address)

description of formations encountered	from	to
SURFACE	0	18
SAND	18	42
SHALE-STARKS SAND	42	320
SHALE-ROCK	320	480
SAND	480	500

WELL LOCATION:  
sec. 22 T 12 N R 1 E  
5 miles West of Pickens  
(distance) (direction) (nearest town)

WELL PURPOSE: INDUSTRIAL  
(home, irrigation, municipal, industrial)

- WELL COMPLETION DATA:
- (1) diameter (inches) 3
  - (2) total depth (feet) 500
  - (3) static water level (feet) 110 below top of ground.
  - (4) casing Steel, 480 (material) (depth)
  - 3 (size) if telescope see back.
  - (5) screen 20, 480 (length) (depth to top)
  - 3, STAINLESS (size) (material)
  - (6) pump air, 75 (HP) (yield gpm)
  - (type power)
  - (7) electric log No (yes or no)
  - (organization running log)
  - (8) how well bottom plugged  
dropped plug

CODED


RECEIVED  
FEB - 7 1986

Department of Natural Resources  
Bureau of Land & Water Resources

DRILLERS REMARKS:  
to be pulled in  
90 days -

If well telescopes please sketch and show depths.

GROUND LEVEL

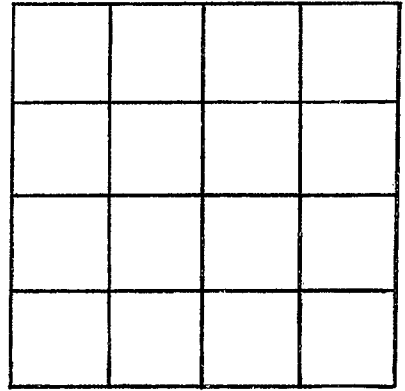

SECTION \_\_\_\_\_

Please indicate well location X.

ADDITIONAL INFORMATION

If more than one screen,  
show locations of each on sketch.