

MISSISSIPPI DEPARTMENT OF NATURAL RESOURCES

Bureau of Land and Water Resources

Southport Mall

P.O. Box 10631

Jackson, Mississippi 39209

WATER WELL DRILLERS LOG

Yazoo
C-29
7-1-88

Copied


July 1 1988 E.M. Bud Cresswell Yazoo
date well completed firm name county well located

LANDOWNER:	description of formations encountered	from	to
<u>NO. 1</u> <u>Harris Swager</u> <u>Benton Mo. 39039</u> (mailing address)	<u>Surface</u>	<u>0</u>	<u>25</u>
	<u>Black Clay</u>	<u>25</u>	<u>35</u>
	<u>sand-shales</u>	<u>35</u>	<u>60</u>
	<u>fine sand</u>	<u>60</u>	<u>110</u>
	<u>shale</u>	<u>110</u>	<u>160</u>
	<u>sand - lignites</u>	<u>160</u>	<u>185</u>
	<u>shale</u>	<u>185</u>	<u>220</u>
	<u>sand - shales</u>	<u>220</u>	<u>380</u>
	<u>shale</u>	<u>380</u>	<u>445</u>
WELL LOCATION:			
sec. <u>13</u> T <u>12</u> N R <u>1</u> E			
<u>2</u> miles <u>EAST</u> of <u>Midway</u>			
(distance) (direction) (nearest town)			
WELL PURPOSE: <u>farm</u>			
(home, irrigation, municipal, industrial)			
WELL COMPLETION DATA:			
(1) diameter (inches) <u>4</u>			
(2) total depth (feet) <u>380</u>			
(3) static water level (feet) <u>105</u> below top of ground.			
(4) casing <u>PVC</u> <u>280</u>			
(material) (depth)			
<u>4</u> if telescope see back.			
(size)			
(5) screen <u>100</u> <u>280</u>			
(length) (depth to top)			
<u>4</u> <u>PVC</u>			
(size) (material)			
(6) pump <u>5</u> <u>70</u>			
(HP) (yield gpm)			
(type power)			
(7) electric log <u>yes</u>			
(yes or no)			
<u>state</u>			
(organization running log)			
(8) how well bottom plugged <u>hard shale</u>			
DRILLERS REMARKS:			

MISSISSIPPI DEPARTMENT OF NATURAL RESOURCES
BUREAU OF LAND AND WATER RESOURCES
JUL 05 1988

If well telescopes please
sketch and show depths.

GROUND LEVEL

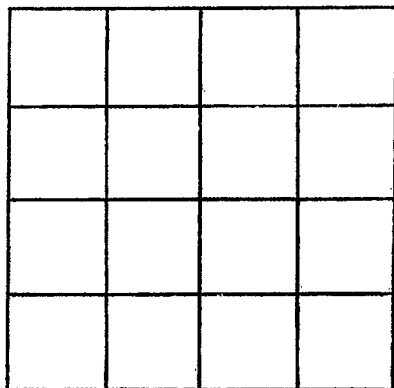

SECTION _____

Please indicate well location X.

ADDITIONAL INFORMATION

If more than one screen,
show locations of each on sketch.