

MISSISSIPPI DEPARTMENT OF NATURAL RESOURCES

Bureau of Land and Water Resources

Southport Mall

P.O. Box 10631

Jackson, Mississippi 39209


WATER WELL DRILLERS LOG

YA200
C30
7/5/88

Coded

July 5 1988 EM. Luc Casswell YA200
 date well completed firm name county well located


LANDOWNER:	description of formations encountered	from	to
No. 2 <i>Harris Swanze</i>			
<i>Benton, Mo. 39039</i> (mailing address)	<i>Surface</i>	0	20
	<i>yellow clay</i>	20	40
	<i>shale</i>	40	60
	<i>fine sand - rock 70</i>	60	80
	<i>shale shale</i>	80	275
	<i>sand shale sh</i>	275	410
WELL LOCATION: sec <u>13</u> T <u>12N</u> R <u>1E</u> <u>2</u> miles <u>EAST</u> of <u>Midway</u> (distance) (direction) (nearest town)			
WELL PURPOSE: <u>farm</u> (home, irrigation, municipal, industrial)			
WELL COMPLETION DATA:			
(1) diameter (inches) <u>4</u>			
(2) total depth (feet) <u>410</u>			
(3) static water level (feet) <u>90</u> below top of ground.			
(4) casing <u>PVC</u> , <u>310</u> (material), (depth)			
<u>4</u> (size) if telescope see back.			
(5) screen <u>100</u> , <u>310</u> (length), (depth to top)			
<u>4</u> , <u>PVC</u> (size), (material)			
(6) pump <u>5</u> , <u>70</u> (HP), (yield gpm)			
(type power)			
(7) electric log <u>yes</u> (yes or no)			
<u>State</u> (organization running log)			
(8) how well bottom plugged <u>Seal Shale</u>			

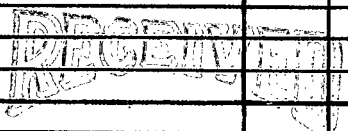

DRILLERS REMARKS:

If well telescopes please sketch and show depths.

GROUND LEVEL

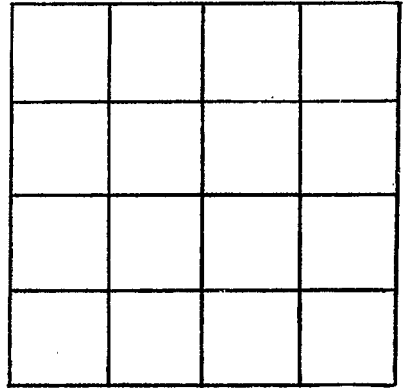

SECTION _____

Please indicate well location X.

ADDITIONAL INFORMATION

If more than one screen, show locations of each on sketch.